

Section 36 Township 19 Range 12WWell No. #3 F. BirzerCompany W. L. Hartman

NORTH

C							

WEST

EAST

SOUTH

Sec. 36 Twp. 19 R. 12W

Well No. #3 F. Birzer Farm

W. L. Hartman Company

Hartman Contractor

Hammer


 Ft. from N. Line

330 Ft. from S. Line

 Ft. from E. Line

330 Ft. from W. Line

SW SW NW

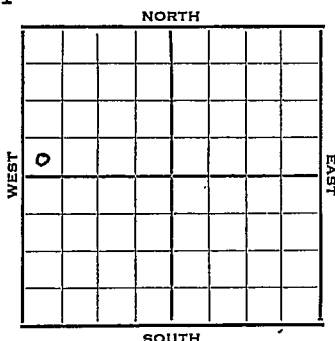

1952 Elev. 1799' REPORT

2/27 Spud 2-24-52
8" @ 155'
Drlg. 1775'

3/4 Heeb. 2941 Lans. 3077
Drlg. 3141'

3/11 Cong. 3355 Arb. 3361
TD 3363 5" @ 3361

3/19 WOCT

3/25 WOCT

4/1 DD to 3376' TD S/27 BOPH for 12 hrs.

4/9 NR

4/16 Spud 2-24-52
Oil Well TD 3376 8" @ 155'
Heeb. 2941 Lans. 3077
Cong. 3355 Arb. 3361
TD 3363 5" @ 3361 DD 3376
S/ 27 B0 12 hr.
Comp. 87 bopd 4% wtr.

COMPLETED

County Barton State KansasSec. 36 (Blk. Twp.) 19 (Sur. Rge.) 12N Map No.Operator W. L. HartmanWell No. 3 Farm F. BirzerElev. Location SW SW NW

FIRST REPORT

330 Ft. From S Line NW330 Ft. From W Line Quarter1st. Report FEB 27 1952

Completion

Remarks

Hartman - Contr.Spudding Date 2-24-52Drlg. Data Hammer8" @ 155 Drlg. 1775

J. G. McGEHEE

