

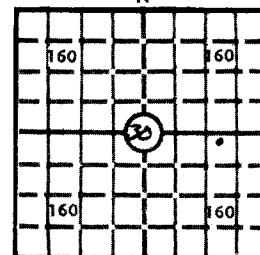
KANSAS DRILLERS LOG

State Geological Survey
WICHITA, BRANCHAPI No. 15 — 113 — 20,349
County Number

S. 30 T. 19 R. 4 W

Loc. 1550' FWL & 200' FNL SE

County McPherson

640 Acres
N

Locate well correctly

Elev.: Gr. 1543.09

DF KB

Operator

Skelly Oil Company

Address

Box 3 Conway, Kansas 67434

Well No.

#34

Lease Name

Conway Underground LPG Storage

Footage Location

200'

feet from (N) line

1090'

feet from (E) line

Principal Contractor

Sterling Drilling Co.

Geologist

None

Spud Date

May 10, 1976

Total Depth

685'

P.B.T.D.

Date Completed

May 12, 1976

Oil Purchaser

None

CASING RECORD

Report of all strings set—surface, intermediate, production, etc.

Purpose of string	Size hole drilled	Size casing set (in O.D.)	Weight lbs/ft.	Setting depth	Type cement	Sacks	Type and percent additives
Surface	25"	20"	52.73#	161'	50/50 Posmix w/3% CaCl	225	
Product	17 1/4"	13-3/8"	48#	553'	Salt Sat 50/50 Posmix	550	

LINER RECORD

PERFORATION RECORD

Top, ft.	Bottom, ft.	Sacks cement	Shots per ft.	Size & type	Depth interval

Size	Setting depth	Packer set at			

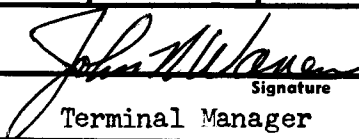
ACID, FRACTURE, SHOT, CEMENT SQUEEZE RECORD

Amount and kind of material used	Depth interval treated

INITIAL PRODUCTION

Date of first production	Producing method (flowing, pumping, gas lift, etc.)				
RATE OF PRODUCTION PER 24 HOURS	Oil bbls.	Gas MCF	Water bbls.	Gas-oil ratio	CFPB
Disposition of gas (vented, used on lease or sold)			Producing interval(s)		

INSTRUCTIONS: As provided in KCC Rule 82-2-125, within 90 days after completion of a well, one completed copy of this Drillers Log shall be transmitted to the State Geological Survey of Kansas, 4150 Monroe Street, Wichita, Kansas 67209. Copies of this form are available from the Conservation Division, State Corporation Commission, 3830 So. Meridian (P.O. Box 17027), Wichita, Kansas 66217. Phone AC 316-522-2206. If confidential custody is desired, please note Rule 82-2-125. Drillers Logs will be on open file in the Oil and Gas Division, State Geological Survey of Kansas, Lawrence, Kansas 66044.

Operator Skelly Oil Company		DESIGNATE TYPE OF COMP.: OIL, GAS, DRY HOLE, SWDW, ETC.:	
Well No. 34	Lease Name Skelly Oil Co. Conway U/G Storage Terminal		Storage LPG
S30 T19S R4 E W			
WELL LOG		SHOW GEOLOGICAL MARKERS, LOGS RUN, OR OTHER DESCRIPTIVE INFORMATION.	
Show all important zones of porosity and contents thereof; cored intervals, and all drill-stem tests, including depth interval tested, cushion used, time tool open, flowing and shut-in pressures, and recoveries.			
FORMATION DESCRIPTION, CONTENTS, ETC.	TOP	BOTTOM	NAME
Wellington Salt Ran GammaRay-Neutron Log	422'		
USE ADDITIONAL SHEETS, IF NECESSARY, TO COMPLETE WELL RECORD.			
Date Received	<div style="text-align: right;">  Signature Terminal Manager Title May 30, 1976 Date </div>		