


Section 4 Township 19 Range 11 W

Well No. # 1 Klepper

Company Henderson Oil

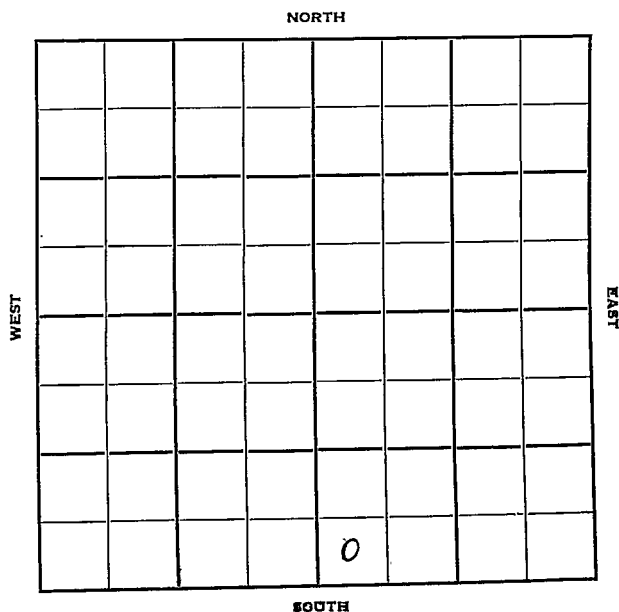

Barton

KANSAS

Sec. 4 Twp. 19 R. 11 W

Well No. # 1 Klepper Farm ☒

Henderson Oil Company

Tod Drlg. Contractor

Wildcat


 Ft. from N. Line

330 Ft. from S. Line

 Ft. from E. Line

330 Ft. from W. Line

SW SW SE

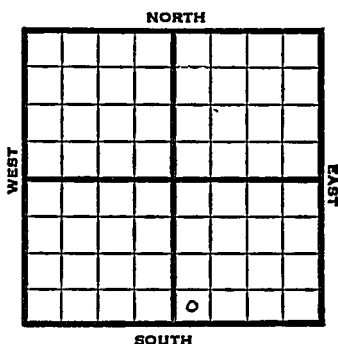

1951 Elev. 1777' REPORT

10/3 Spud 9-29-51
8" @ 325' Anhy 585'
Drlg. 1100'

10/24 Spud 9-29-51
D&A TD 3411
8" @ 325'
Anhy 585 Heeb. 2957
Br. 1m. 3074 Lans. 3094
DST 3096-3160 open 1 hr.
Rec. 30' mud
Cong. 3383 Arb. 3392
TD 3411
D&A

ABANDONED

County Barton State Kansas
 Sec. 4 (Blk. Twp.) 19 (Sur. Rge.) 11W Map No.
 Operator Henderson Oil
 Well No. 1 Farm Klepper
 Elev. Location SW SW SE

FIRST REPORT

0

330 Ft. From S Line SE
330 Ft. From W Line Quarter
 1st. Report OCT 3 1951
 Completion
 Remarks
Todd Drlg. - Contr.
 Spudding Date 9-29-51

Drlg. Data Wildcat

8" @ 325 Anhy 585 drlg. 1100


J. E. TYRA

County Barton State Kansas
 Sec. 4 (Blk.) 19 (Sur.) 11W Map No.
 (Twp.) (Rge.)

Operator Henderson Oil

Well No. 1 Farm Klepper

Elev. 1777 Location SW SW SE

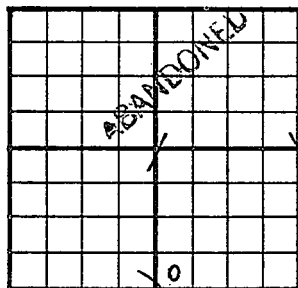

330 Ft. From S Line SE

330 Ft. From W Line Quarter

Ist. Report

Completion OCT 24 1951

Remarks Wildcat

Todd Drlg. - Contr.

Spudding Date 9-29-51

Drlg. Data D & A TD 3411

8" @ 325 Anhy 585 Heeb. 2957

Br. lime 3074 Lans. 3094 DST 3096-3160

open 1 hr. Rec. 30' mud Cong. 3383

Arb. 3392 TD 3411

D & A

J. E. TYRA