

KANSAS


FORM 51 5M 6-46 PETROL

Barton county

Section 4 Township 19 Range 11-W

Well No. #1-A, H. Musenberg

Company C. E. Ash

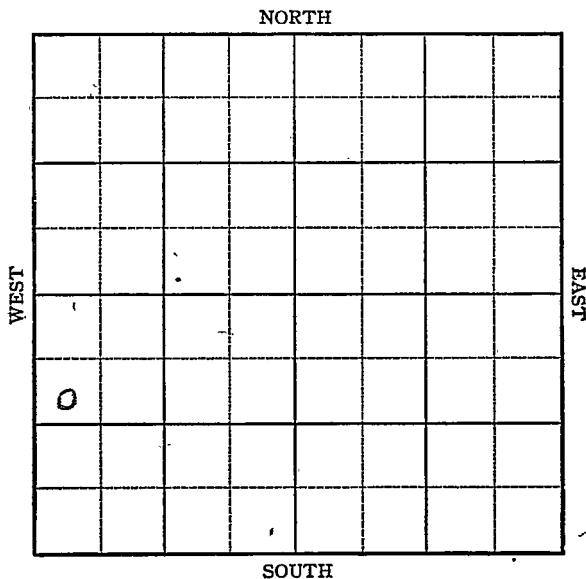

KANSAS

Barton

Sec. 4 Twp. 19 R. 11W

Well No. 1 "A" H. Musenberg Farm
C. E. Ash Company


Silica

990 Ft. from N. Line

 Ft. from S. Line

 Ft. from E. Line

330 Ft. from W. Line

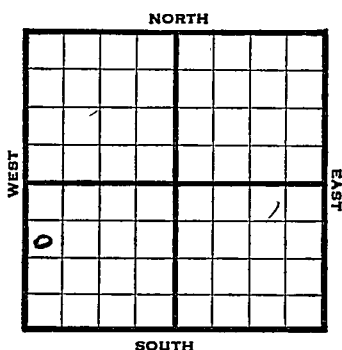

SW NW SW

1946	Elev. 1813' REPORT
11/20	8" @ 206'
	WOC
11/27	Drlg 3000'
12/3	Lans 3081'
	Arb 3385'
	TD 3 390
	5" @ 3386', RUST
12/10	" "
12/17	" "
1947	
1/4	Drlg 3391' SO
1/8	TD 3 399'
	200' oil 12 hrs.
1/15	SD
1/21	"
1/30	"
2/5	"
2/12	"
2/19	Drlg 3430'

OVER

2/26 TD 3430'
1000 Acid

3/5 BP 3393'

3/12 Arb 3385'
5" @ 3386'

ABANDONED

Map No. 46 Sec. 4 Twp. 19 R. 11W

Well No. 1 "A" H. Musenberg

C. E. Ash Company

FIRST REPORT

Contractor

SW NW SW

SECTION PLAT

o			

990 Ft. from N. Line

 Ft. from S. Line

 Ft. from E. Line

330 Ft. from W. Line

Barton County

Location

Rig up

Drilling and Remarks:

8" @ 206 WOC

RECORD

Cased in., ft.

Sand

Gas

Oil

Total Depth

PRODUCTION

1st 24 hrs. Nat.

1st 24 hrs. after shot

Gas Cu. Ft.

Dry Hole

Abandoned

Date


NOV 20 1946

19

S. J. LEWIS

Scout

1914

 

Small Maps

18 Sarah

2222

Map

ough Map

Pierce

Geological Dept.

Pierce Plat book

Map No. 46 Sec. 4 Twp. 19 R. 11W

Well No. 1 "A" H. Musenberg

C. E. Ash Company

ABANDONED

Contractor

SW NW SW

E 11813
SECTION PLAT

6			

990 Ft. from N. Line

 Ft. from S. Line

 Ft. from E. Line

330 Ft. from W. Line

Barton County

Location

Rig up

Drilling and Remarks:

Per 3385

5" @ 3386

RECORD

Cased in., ft.

Sand

Gas

Oil

Total Depth 3421

PRODUCTION

1st 24 hrs. Nat.

1st 24 hrs. after shot

Gas Cu. Ft.

Dry Hole

Abandoned

Date

MAR 12 1947 19 S. L. LEWIS Scout

Misc. Small Maps	
Cards	<i>OK</i>
Tracing	<i>me</i>
France Map	<i>OK</i>
Scarborough Map	<i>OK</i>
Pierce Map	<i>me</i>
Geological Dept.	
Pierce Plat Book	