


Map No. KANSAS Sec. 4 Twp. 19 R. 10<sup>W</sup>  
 Well No. Alipwan 1st Farm \_\_\_\_\_ Company \_\_\_\_\_

NORTH

WEST

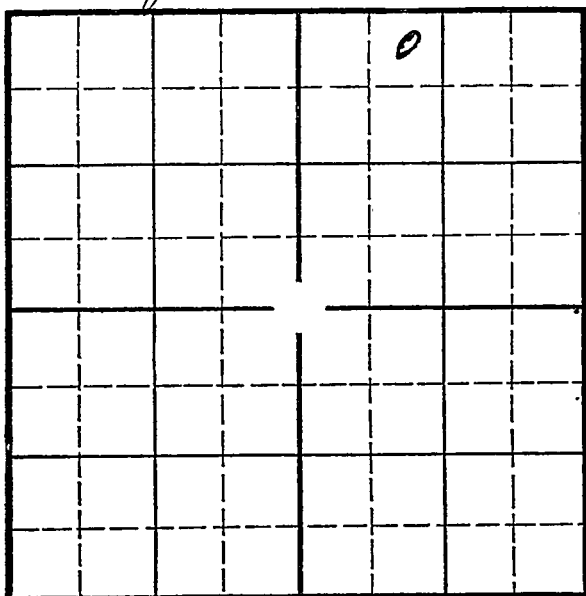

EAST

SOUTH

Location \_\_\_\_\_  
 Drilling Remarks \_\_\_\_\_

Rig Up \_\_\_\_\_  
 Drilling Remarks \_\_\_\_\_

## RECORD

Cased \_\_\_\_\_ in. \_\_\_\_\_ ft.  
 Sand \_\_\_\_\_  
 Gas \_\_\_\_\_  
 Oil \_\_\_\_\_  
 Total Depth \_\_\_\_\_

## PRODUCTION

1st 24 hrs. Nat. \_\_\_\_\_  
 1st 24 hrs. after shot \_\_\_\_\_  
 Gas \_\_\_\_\_ cu. ft. \_\_\_\_\_  
 Dry Hole \_\_\_\_\_  
 Abandoned \_\_\_\_\_

Map No. KANSAS Sec. 4 Twp. 19 R. 10<sup>W</sup>  
Well No. 1-1 Haas Farm  
Alyward et al Company


330 Ft. from N. Line

\_\_\_\_\_ Ft. from S. Line

\_\_\_\_\_ Ft. from E. Line

990 Ft. from W. Line

Elev. 1740

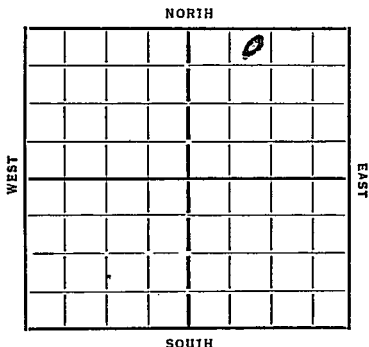

Date 1935 REPORT

8/14 Rig  
8/22 Rig  
8/29 Rig  
9/6 Alg 150  
10/3 " 2695 8" 2444  
10/10 40 3165-73 6" 3185  
10/10 Alg 3245 16" 2960  
10/17 Alg 3319  
TD 3365

D. T. A.

**ABANDONED**

Map No. 46 Sec. 4 Twp. 19 R. 10WWell No. 1-HassAlward et al Company

Contractor

ABANDONED

## SECTION PLAT

|  |  |   |  |
|--|--|---|--|
|  |  | 0 |  |
|  |  |   |  |
|  |  |   |  |
|  |  |   |  |
|  |  |   |  |

330 Ft. from N. Line

Ft. from S. Line

Ft. from E. Line

990 Ft. from W. Line

## RECORD

Location

Rig up

Drilling and Remarks:

Cased \_\_\_\_\_ in. \_\_\_\_\_ ft.

Sand Sil 3319

Gas \_\_\_\_\_

Oil \_\_\_\_\_

Total Depth 3365

## PRODUCTION

1st 24 hrs. Nat. \_\_\_\_\_

1st 24 hrs. after shot \_\_\_\_\_

Gas \_\_\_\_\_ Cu. Ft.

Dry Hole \_\_\_\_\_

Abandoned \_\_\_\_\_

Date

10-17-35 192

DRYAL MANNING &amp; SONS

KANSAS

Map No. 46 Sec. 4 Twp. 19 R. 10WWell No. 1-H-11Alward et al Company

Contractor

FIRST REPORT  
COMPLETE

## SECTION PLAT

|  |  |   |  |
|--|--|---|--|
|  |  | 0 |  |
|  |  |   |  |
|  |  |   |  |
|  |  |   |  |
|  |  |   |  |

330 Ft. from N. Line

Ft. from S. Line

Ft. from E. Line

990 Ft. from W. Line

FIRST REPORT

Location

Rig up

Drilling and Remarks:

## RECORD

Cased \_\_\_\_\_ in., \_\_\_\_\_ ft.

Sand \_\_\_\_\_

Gas \_\_\_\_\_

Oil \_\_\_\_\_

Total Depth \_\_\_\_\_

## PRODUCTION

1st 24 hrs. Nat. \_\_\_\_\_

1st 24 hrs. after shot \_\_\_\_\_

Gas \_\_\_\_\_ Cu. Ft.

Dry Hole \_\_\_\_\_

Abandoned \_\_\_\_\_

Date

ORVAL MANNSCHRECK

8-14-35 192

Scout