
FORM 51 25M 3-49 PETROL

Rice KANSAS

Section 4 Township 19 Range 10 W

Well No. # 1 Ringwald

Company Harms & Knight

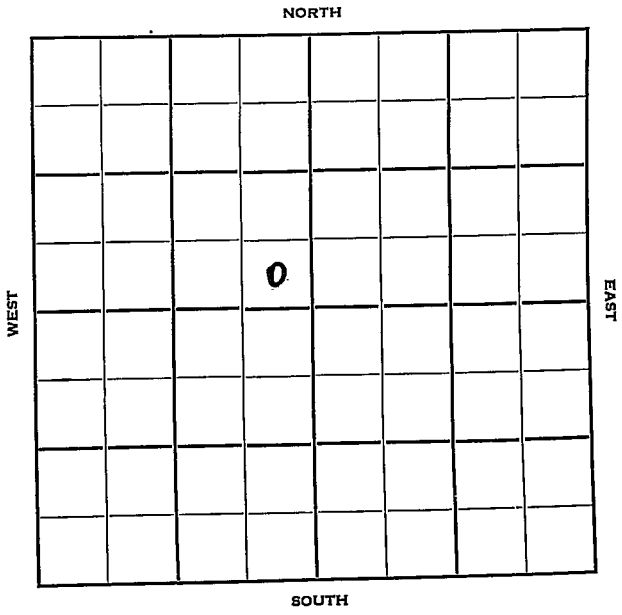

FORM 252-B
10M 10-50 PETROL

Rice

KANSAS

Sec. 4 Twp. 19 R. 10W

Well No. #1 Ringwald Farm

Harms & Knight Company

" Contractor

IXL Pool


____ Ft. from N. Line

330 Ft. from S. Line

330 Ft. from E. Line

____ Ft. from W. Line

SE SE NW

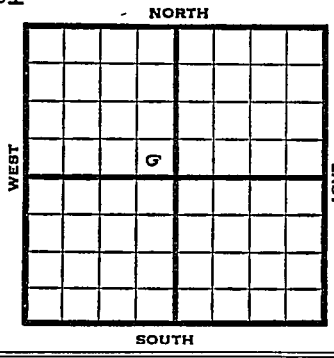

1952	Elev. 1750' REPORT
9/4	Spud 8-29-52 8" @ 204' Drlg. 1895'
9/10	Heeb 2835' Tor. 2857' Br Li 2959' Lans. 2981' Cong. 3282' Arb 3294' Circu @ 3305'
9/17	DST 3305-15, 15hr. 20' MCO 20' OCM 550# RTD 3336' 5" @ 3322
9/24	NR
10/1	CO 3336' Fill up 1000' oil S/3 BOPH POP
10/8	"
10/15	"
10/22	NR
10/29	"
11/5	NR
11/12	NR
11/20	"
11/27	"
12/4	"
12/11	Testing
12/18	Testing
12/25	Testing

OVER

1953Y

1/1 Testing
1/8 Testing
1/22 "
1/29 "
2/5 NR
2/11 Spud 8-29-52
OilWell
TD 3336
8" @ 204
Heeb 2835, Tor 2857, Br lime 2959, Lans 2981, Cong 3282, Arb. 3294
DST 3305-15, opn 1 hr., rec. 20' mco, 20' ocm, 550#
TD 3336
5" @ 3322
CO to 3 336
FU 1000' oil
S/3 boph P/20 bopd 12% wtr.
Dec. to 10 bopd 14% wtr.
Dec. to 5 bopd 32% wtr
S/2 boph
Comp. 5 bopd 20% wtr.

COMPLETED

FORM 275 FOR SALE BY KANSAS BLUE PRINT CO.


County Rice State Kansas

Sec. 4 (Blk. Twp.) 19 (Sur. Rge.) 10W Map No.

Operator Harms & Knight

Well No. 1 Farm Ringwald

Elev. 1750 Location SE SE NW

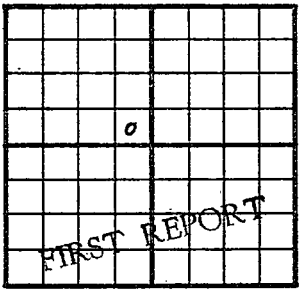

330 Ft. From S Line NW

330 Ft. From E Line Quarter

1st. Report SEP 4 1952

Completion

Remarks

Harms & Knight - Contr.

Spudding Date 8-29-52

Drlg. Data IXL Pool

8" @ 204 drlg. 1895

J. G. McGEHEE

Scout Cards .....
Land Small Map .....
Land Wall Map .....
Tracings .....
France Map .....
Pierce Map .....
Misc. .....

Drlg. Data

FORM 275 FOR SALE BY KANSAS BLUE PRINT CO.


County Rice State Kansas

Sec. 4 (Blk. Twp.) 19 (Sur. Rge.) 10W Map No.

Operator Harms & Knight

Well No. 1 Farm Ringwald

Elev. 1750 Location SE SE NW

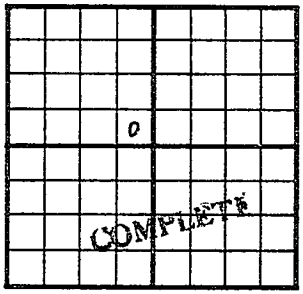

330 Ft. From S Line NW

330 Ft. From E Line Quarter

1st. Report

Completion FEB 11 1953

Remarks IXL Pool

Harms & Knight - Contr.

Spudding Date 8-29-52

Drlg. Data Oil well TD 3336

8" @ 204 Heeb. 2835 Tor. 2857

Br. lime 2959 Lans. 2981 Cong. 3282

Arb. 3294 DST 3305-15 open 1 hr. Rec.

20' mco 20' ocm 550# TD 3336

5" @ 3322 CO to 3336 FU 1000' oil

S/ 3 boph P/ 20 bopd 12% wtr.

Dec. to 10 bopd 14% wtr. Dec. to 5 bopd

32% wtr. S/ 2 boph

Comp. 5 bopd 20% wtr.

J. G. McGEHEE

FEB 18 1953.

Scout Cards

Land Small Map

Land Well Map

Tracings

France Map

Pierce Map

Misc.

Drlg. Data