


Rice

KANSAS

Section 4 Township 19 Range 10W

Well No. #1 Schmidt

Company Florney & Williams

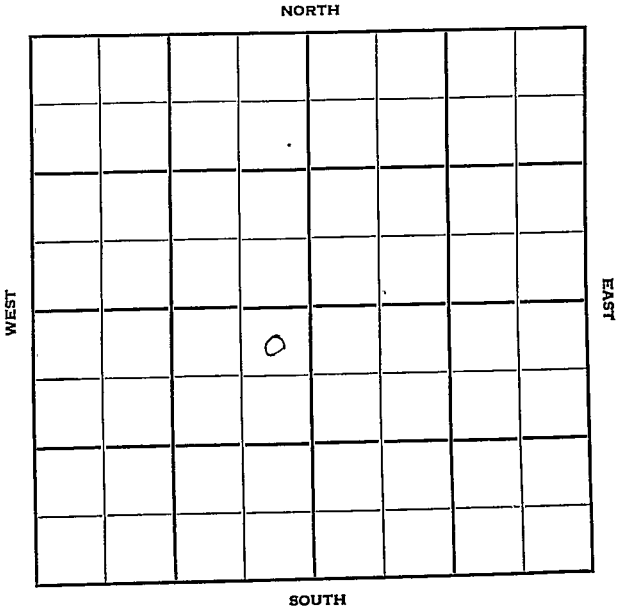

Rice
19

KANSAS 10W

Sec. 4 Twp. _____ R. _____

Well No. #1 Schmidt Farm _____

Florney & Williams Company _____

Wildcat


330' Ft. from N. Line

_____ Ft. from S. Line

330' Ft. from E. Line

_____ Ft. from W. Line

NE NE SW

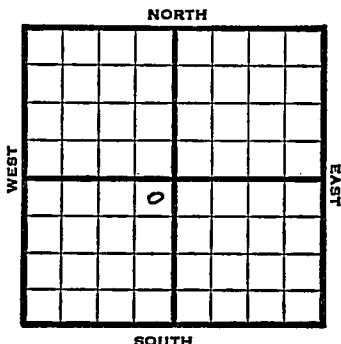

1950

Elev 1756'

REPORT

1/11

Location

3/15

TD 3335'

8" @ 170'

5" @ 3312'

Lans 2993'

Arb. 3308'

135 BOPD

Comp

COMPLETED

Kansas

Wildcat

Map No. _____ Sec. 4 Twp. 19 R. 10WWell No. 1 SchmidtFlorney & Williams CompanyLewis Drlg. Contractor

NE NE SW

SECTION PLAT

FIRST	REPORT		
	o		

330 Ft. from N. Line

_____ Ft. from S. Line

330 Ft. from E. Line

_____ Ft. from W. Line

Rice County

Location X

Rig up _____

Drilling and Remarks: _____

RECORD

Cased _____ in., _____ ft.

Sand _____

Gas _____

Oil _____

Total Depth _____

PRODUCTION

1st 24 hrs. Nat. _____

1st 24 hrs. after shot _____

Gas _____ Cu. Ft.

Dry Hole _____

Abandoned _____

Date

JAN 11 1950 19J. E. TYRA Scout

Map No. _____ Sec. 4 Twp. 19 R. 10W

Well No. 1 Schmidt

Florney & Williams Company

Contractor

NE NE SW

E/ 1756
SECTION PLAT

330 Ft. from N. Line

_____ Ft. from S. Line

330 Ft. from E. Line

_____ Ft. from W. Line

	COMPLETE		
	0		

Rice County

Location _____

Rig up _____

Drilling and Remarks:

8" @ 170

5" @ 3312

Leas 2993

and 3308

135 BOPD

RECORD

Cased _____ in., _____ ft.

Sand _____

Gas _____

Oil _____

Total Depth 3335

PRODUCTION

1st 24 hrs: Nat. _____

1st 24 hrs. after shot _____

Gas _____ Cu. Ft.

Dry Hole _____

Abandoned _____

Date

MAP 15 1950

19

J. E. TYRA

Scout