


Section 4 Township 19 Range 10 W

Well No. # 1 Schmidt

Company Lewis Drlg.

NORTH

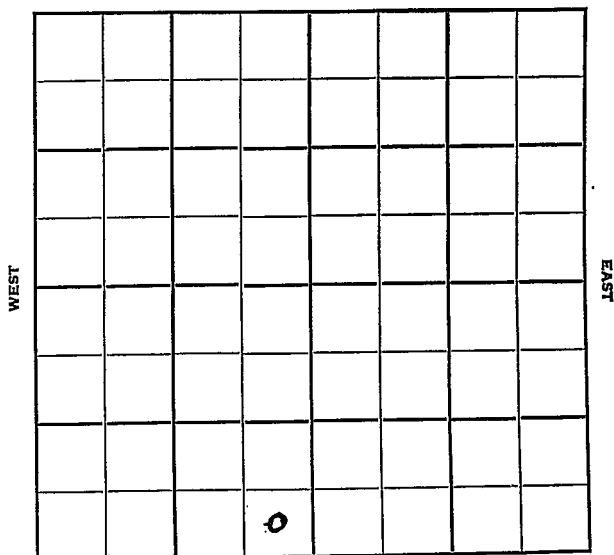

SOUTH

Sec. 4 Twp. 19 R. 10 W

Well No. # 4 Schmitt Farm

Lewis Drlg. Company

Lewis Drlg. Contractor


\_\_\_\_\_ Ft. from N. Line

330 Ft. from S. Line

330 Ft. from E. Line

\_\_\_\_\_ Ft. from W. Line

SE SE SW

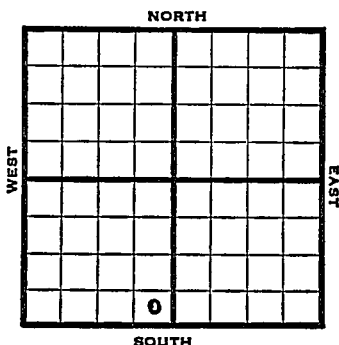

1952

Elev. 1762'

REPORT

5/28

Spud 5-24-52  
8" @ 207'  
Drlg: 1485'

6/11

Lans. 3000'  
DST 2978-3007', 1½ hr, 65' GCM  
DST 3058-76, 1 hr, 60' slt wtry 0 & GCM  
Cong. 3298' Arb. 3308-41' RTD  
5" @ 3341'

6/18

CO 3338 Electric log  
31/3328-34½ 1 BOPH 500 A  
S/8 BOPH 64/3316-24 1000 A  
S/16 BOPH for 3 hrs.  
34/3334-40 35/3332-38 500 A  
S/38 BOPH for 4 hrs. tub & rods

6/25

NR

7/2

"

7/9

Spud 5-24-52 Oil well TD 3341'  
8" @ 207' Lans. 3000'  
DST 2978-3007' open 1½ hr. rec 65' GCM  
0#  
DST 3058-76 open 1 hr. rec 60' SW 0 & GCM 170# Cong. 3298' Arb. 3308'  
5" @ 3341' CO to 3338' 31/3328-34  
1 BOPH 500 A S/8 BOPH 64/3316-24  
1000 A S/16 BOPH 34/3334-40 35/3332-38  
500 A S/38 BOPH  
Comp. 568 BOPD

**COMPLETED**



