

Rice

KANSAS


SECTION 4 TOWNSHIP 19S RANGE 10W

WELL NO. #6 Schmidt

COMPANY Wood Petr. Co.

NORTH

~~NW SE SW~~
~~SW NE SW~~

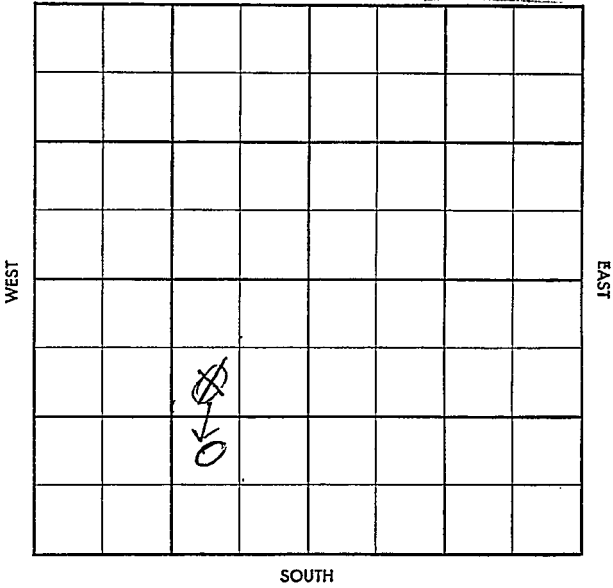

FIRST REPORT

CO. ~~Rice~~ ELEV. _____
SEC. ~~4~~ TWP. 19 RGE. 10W
COMPANY ~~Wood Pet. Co.~~ NO 6

JAN 2 '58		
o		

FARM Schmidt

LOC. SW NE SW

GEOL. Don Vaughan

CONTR. Triangle tools

POOL IXL

SPUD 12/28/57

8" @ 246 Drlg. 1354.

CO.
LSE.
NO.
SEC.
TWP.
RGE.

CORRECTION

12

Co. Rice

ELEV. 17610F
1764KB

SEC. 4 TWP. 19 RGE. 10W

COMPLETE

COMPANY Wood Pet. Co. NO. 6

FEB 19 58

FARM Schmidt

LOC. SW NE SW NW SE SW

A 486
H 2939
Ls 2985
C 3300
Ar 6 3315
TD 3320

GEOL. Don Vaughan

CONTR. Triangle tools

POOL IXL

SPUD 12/28/57

8" @ 24.6 DFL 1354

JAN 8 58 X 760PS

DST 3070-80 op 60"

1620' gip 60' MD

BHP 660/20" DST

3159-68 op 60"

160' WM BHP 920/20" DST

3187-3220 op 30" 5' M

BHP 120/15" d 3320 JAN 15 58

5" 3318 w/c JAN 22 58 DD 3326T

130' h 1/2 \$ 6 BOP h NW

500' OB POP JAN 23 58 FEB 5 58

FEB 12 58 FEB 19 58 P 75 BOP d NW

P 25 BOP d NW

CO

15E

NO

SEC

TWP

RGE