


Section 4 Township 19 Range 2 W

Well No. # 1 Johnson

Company Bennett & Roberts

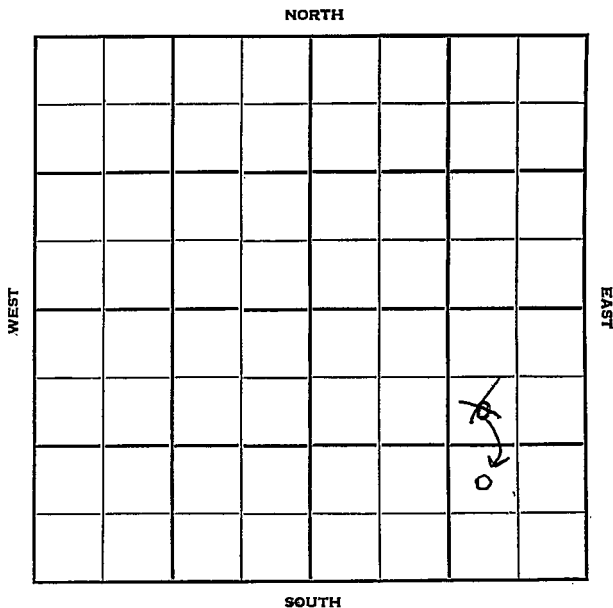

Sec. 4 Twp. 19 R. 2W

Well No. #1 Johnson Farm

Bennett & Roberts. Company

Trans Era Contractor

Ritz-Canton Pool


~~990~~ Ft. from N. Line

990 Ft. from S. Line

990 Ft. from E. Line

\_\_\_\_\_ Ft. from W. Line

~~NW SE SE~~  
~~SW NE SE~~

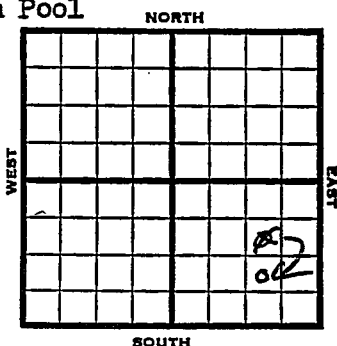

1953 Elev. 1562' REPORT

6/24 Spud 6-18-53  
8" @ 158'  
Drlg 1810'

7/1 Heeb 2098, Doug 2126, Br. L. 2287,  
Lans 2344, KC 2346, Cong 3943  
DST 2952-72, 2 hrs, 50' M, 190#  
20" Miss 2960  
Drlg 3003'

7/8 Spud 6-18-53  
D&A  
TD 3035  
8" @ 158  
Heeb 2098, Doug 2126, Br lime 2287,  
Lans 2344, KC 2346, Cong 2943  
DST 2952-75, opn 2 hrs., rec. 50' mud  
190#,  
Miss 2960  
TD 3035  
D&A

ABANDONED



KANSAS

Map No. \_\_\_\_\_ Sec. 4 Twp. 19 R. 2W

Well No. 1 Johnson

B & R Drlg. Company

**CORRECTION**

Contractor

NW SE SE

SECTION PLAT

\_\_\_\_\_ Ft. from N. Line

990 Ft. from S. Line

990 Ft. from E. Line

\_\_\_\_\_ Ft. from W. Line

			o

McPherson County

Location \_\_\_\_\_

Rig up \_\_\_\_\_

Drilling and Remarks:

Reported  
SW NE SE

RECORD

Cased \_\_\_\_\_ in., \_\_\_\_\_ ft.

Sand \_\_\_\_\_

Gas \_\_\_\_\_

Oil \_\_\_\_\_

Total Depth \_\_\_\_\_

PRODUCTION

1st 24 hrs. Nat. \_\_\_\_\_

1st 24 hrs. after shot \_\_\_\_\_

Gas \_\_\_\_\_ Cu. Ft.

Dry Hole \_\_\_\_\_

Abandoned \_\_\_\_\_

Date

JUL 22 1953

J. G. McGEHEE Scout

