


Section 4 Township 19 Range 11W


Well No. #1 Musenberg

Company Eugene Huebner & Fred Asbury

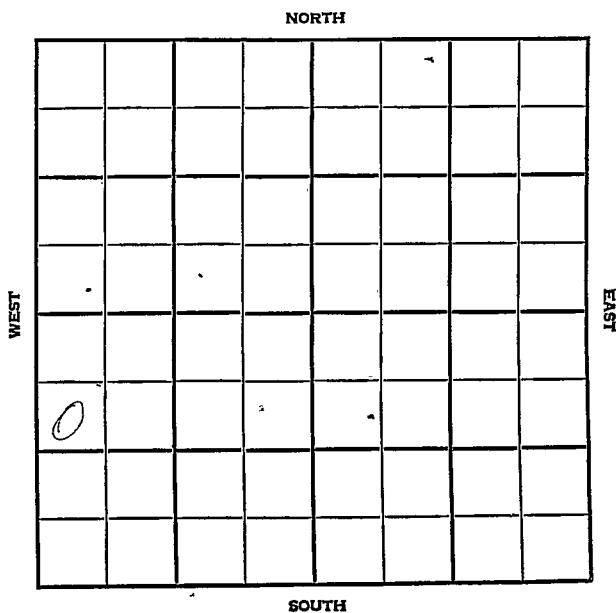

County Barton Elev. _____
 Sec. 4 Twp. 19 Rgs. 11W
 Company Eugene Huebner and Fred Asbury
 FarmName Musenberg No. 1

TOPS	DEPTH	LOG	DATUM	Loc. in Sec.
Anb.	611			SW NW SW
Ip.				
H.	2972			75' NW of D&A
Tr.	2994			
Dg.	3002			
BL.	3090			
L.				Geol. _____
K.C.				Contr. _____
B.K.C.				
Ce.				Shelley- Miller
C.				Tools
M.				Pool
M.				St. Peter
K.				
Mz.				
Me.				
V.				
S.				
S.				FIRST REPORT
A.				
R.				
PE.				
G.				
T.D.	3107			

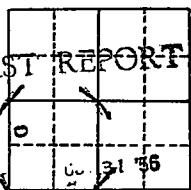

Date Comm.spd. 10-23-56
8" @ 290 w/125, Dst. 3130-3190, 45" mud,
BHP 320 in 20", Drlg. 3397

2001 S 1011

2001 S 1011

Co.

5

No.

Sec.

T.

R.

County Bayton Elev. _____
 Sec. 4 Twp. 19 Rgd. 11W
 Company Eugene Huebner and Fred Asbury
 Farm Name Musenberg No. 1

TOPS	DEPTH	LOG	DATUM	Loc. in Sec.
Anh.	611			SW NW SW
Tr.	2972			75' NW of D&A
H.	2994			
Tr.	2994			
Dg.	3002			
Bl.	3090			
L.				Geol. _____
K.C.				Contr. _____
B.K.C.				Shelley-Miller
Ce.				Tools
C.				Pool
M.				St. Peter
M.				
K.				
Mz.				
Mo.				
V.				
S.				
S.				ABANDONED
A	Rework 3385			
R.	Arb 3414			
PE.				
G.				
TD	3419	3107		

Date Comm. spd. 10-23-56

8" @ 290 w/125, Dst. 3130-3190, 45" mud,

BHP 320 in 20", Drlg. 3397 NOV 7 '56

DST 3383-3419 30" rec 30' Md

BHY 1020/20

D&A

Co.

Er

No.

Sec.

T.

R.