

KANSAS

Barton

Section 4 Township 19 Range 15WWell No. #1 Morton (Merten)Company Cities ServiceAlbert Pool

NORTH

WEST

						Q	

EAST

SOUTH

16

KANSAS

Barton

Sec. 4 Twp. 19 R. 15W

Well No. #1 Morton Farm

Cities Service Company

Albert Pool


Ft. from N. Line

330' Ft. from S. Line

990' Ft. from E. Line

Ft. from W. Line

SW SE SE

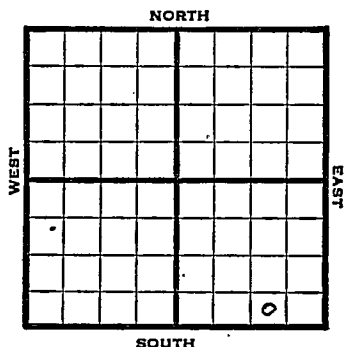

1948

Elev. 1992' REPORT

3/17	Location
3/24	"
3/31	8" @ 972' Drlg. 3130'
4/7	Reagan 3583' TD 3618' 5" @ 3584' RUST
4/14	Lansing 3298' Reagon 3578' 5" @ 3578' TD 3610'
4/21	12 qts. 3583'-95' fsg.
4/28	"
5/5	"
5/12	"
5/19	"
5/26	"
6/1	"
6/9	"
6/16	"
6/23	"

OVER

1948

6/30 Reagan 3578'
5" @ 3578'
TD 3610'

ABANDONED

Map No. _____ Sec. 4 Twp. 19 R. 15W

Well No. 1 Morton

Cities Service Company

FIRST REPORT

Contractor

SW SE SE


SECTION PLAT

_____ Ft. from N. Line

330 Ft. from S. Line

990 Ft. from E. Line

_____ Ft. from W. Line

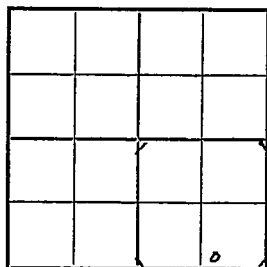

Barton County

Location X

Rig up _____

Drilling and Remarks:

RECORD

Cased _____ in., _____ ft.

Sand _____

Gas _____

Oil _____

Total Depth _____

PRODUCTION

1st 24 hrs. Nat. _____

1st 24 hrs. after shot _____

Gas _____ Cu. Ft.

Dry Hole _____

Abandoned _____

Date

MAR 17 1948 19 _____ S. J. LEWIS Scout

Map No. 82 Sec. 4 Twp. 19 R. 15W

Well No. 1 Merten

Cities Service


Company

ABANDONED

Contractor

SWSE SE

2/1/992
SECTION PLAT

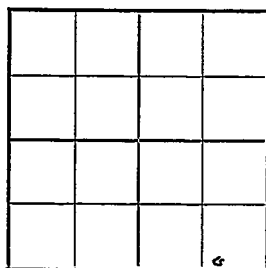

Ft. from N. Line

330 Ft. from S. Line

990 Ft. from E. Line

Ft. from W. Line

Barton County

Location

Rig up

Drilling and Remarks:

*Reagan 3578.
5" @ 3578.*

RECORD

Cased in., ft.

Sand

Gas

Oil

Total Depth 3610

PRODUCTION

1st 24 hrs. Nat.

1st 24 hrs. after shot

Gas Cu. Ft.

Dry Hole

Abandoned

Date

JUN 30 1948

19

S. J. LEWIS

Scout