

KANSAS


Barton

Section 4 Township 19 Range 15W

Well No. 3 Merten

Company Ferrell Drig. et al

Albert

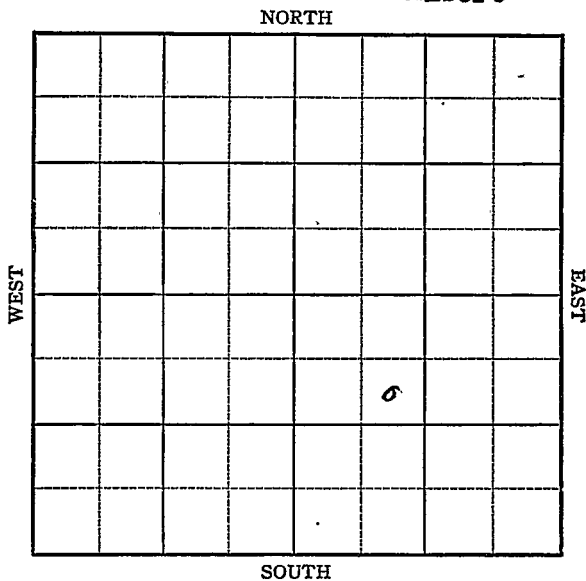

KANSAS

Barton

Sec. 4 Twp. 19 R. 15W ✓

Well No. #3 Merten Farm

Ferrall Drlg. et al Company


Albert (Ferrall Drlg. Cont.) NORTH

Pool 990' Ft. from N. Line

_____ Ft. from S. Line

_____ Ft. from E. Line

990' Ft. from W. Line

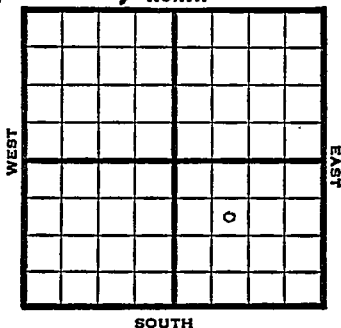

SE NW SE

SOUTH

1949

Elev 1987' REPORT

- 6/1 Anhy 960'
- 8" @ 962'
- 6/7 Drlg. 3257'
- 6/15 Lansing 3273'
- Reagan 3564-90'
- TD 3590'
- 5" @ 3564'
- 6/21 20 qts 3567-85' fsg.
- 6/29 TD 3590' (3590')
- Reagan 3564'
- 5" @ 3564'
- Aband.

ABANDONED

Map No. _____ Sec. 4 Twp. 19 R. 15W

Well No. 3 Merten

Ferrell Drlg. etal. Company

Ferrell Drlg. Contractor

SE NW SE

**FIRST REPORT
SECTION PLAT**

990 Ft. from N. Line

_____ Ft. from S. Line

_____ Ft. from E. Line

990 Ft. from W. Line

Barton County

Location _____

Rig up _____

Drilling and Remarks: .

Anhy 960

8" @ 962

RECORD

Cased _____ in., _____ ft.

Sand _____

Gas _____

Oil _____

Total Depth: _____

PRODUCTION

1st 24 hrs. Nat. _____

1st 24 hrs. after shot _____

Gas _____ Cu. Ft.

Dry Hole _____

Abandoned _____

Date

JUN 1 1949

19

S. J. LEWIS

Scout

