
FORM 51 25M 8-50 WESTERN Barton KANSAS

Section 4 Township 19 Range 15 W

Well No. # 1 Quimby

Company ~~Cities Service Oil~~

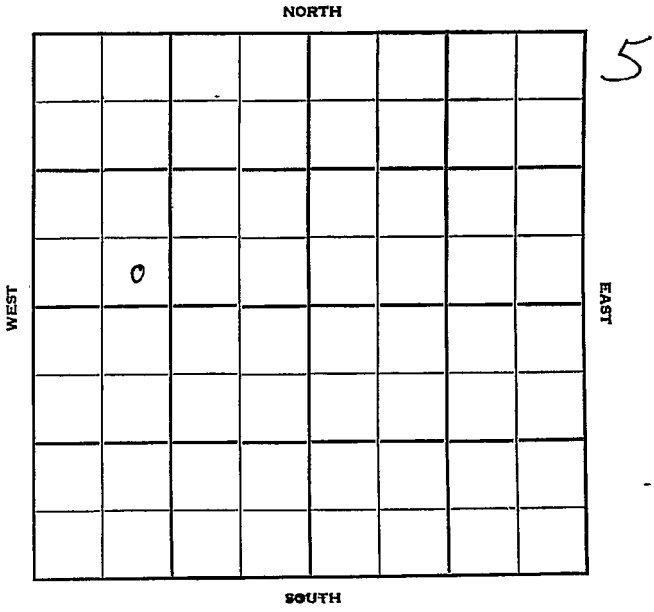

FORM 252-B
10M 11-50 PETROL

Barton KANSAS

Sec. 4 Twp. 19 R. 15 W

Well No. # 1 Quimby Farm

Cities Service Oil Company

Barbour Contractor


Ft. from N. Line

330 Ft. from S. Line

Ft. from E. Line

990 Ft. from W. Line

SE SW NW

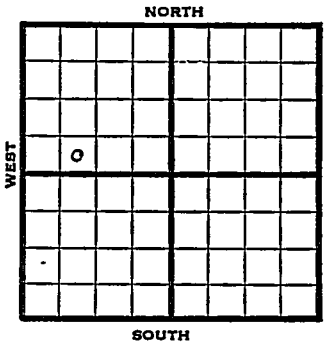

1951	Elev. 2003' REPORT
6/27	Location
8/1	Spud 7-3-51 Oil well TD 3711' 8" @ 991' Lans. 3295' Ch. cong. 3564' Sd. cong. 3580' Gorham 3588' TD 3598' 5" @ 3590' Arb. 3609' TD 3711' FU 1000' gassy oil Hydrofrac Comp. 76 BO 12 BWPD **COMPLETED**

FORM 275 FOR SALE BY KANSAS BLUE PRINT CO.


County Barton State Kansas

Sec. 4 (Blk. Twp.) 19 (Sur. Rge.) 15W Map No.

Operator Cities Service Oil

Well No. 1 Farm Grimby

Elev. Location SE SW NW

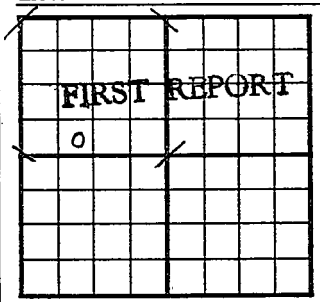

330 Ft. From S Line NW

990 Ft. From W Line Quarter

1st. Report JUN 27 1951

Completion

Remarks

Barbour - Contr.

Spudding Date

Drlg. Data

Location

J. E. TYRA

FORM 275 FOR SALE BY KANSAS BLUE PRINT CO.


County Barton State Kansas

Sec. 4 (Blk. / Twp.) 19 (Sur. / Rge.) 15W Map No.

Operator Cities Service

Well No. 1 Farm Quimby

Elev. 2003 Location SE SW NW

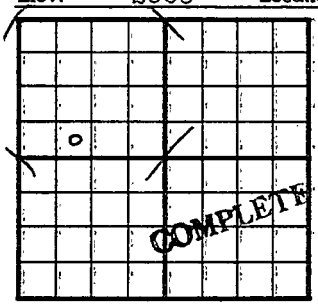

330 Ft. From S Line NW

990 Ft. From W Line Quarter

1st. Report

Completion AUG 1 1951

Remarks:

Barbour - Contr.

Spudding Date 7-3-51

Drlg. Data Oil well TD 3711

8" @ 991 Lans. 3295 Sh. cong. 3564

Sd. cong. 3580 Gorham 3588 TD 3598

5" @3590 Arb. 3609 TD 3711 FU 1000'

gassy oil Hydrofrac

Comp. 76 bo 12 bwpd

J. E. TYRA