

Sec. 4 Twp: 19 R. 15W

Well No. #1 Rogers Farm

Harbar Drlg. Company

Albert Pool


330' Ft. from N. Line

_____ Ft. from S. Line

330' Ft. from E. Line

_____ Ft. from W. Line

NE/C

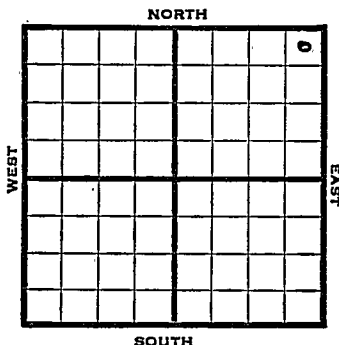

1948 Elev. 1953' REPORT

- 2/4 Location
- 2/11 "
- 2/18 "
- 2/25 Drlg. 300'
- 3/3 Drlg. 2005'
- 3/10 Drlg. 3445'
- 3/17 Lansing 3242'
Arbuckle 3522-25' TD
TD 3525'
5" @ 3522'
RUST
- 3/24 No Arbuckle
Reagan 3522'
- 3/31 TD 3561'
PB 3450'
24 shots 3415-20
500 acid
No shows.
- 4/7 Reagan 3522'
TD 3566'
ABANDONED

Map No. _____ Sec. 4 Twp. 19 R. 15W

Well No. 1 Rogers

Harbar Drlg. Company

FIRST REPORT

Contractor

NE/C


SECTION PLAT

330 Ft. from N. Line

_____ Ft. from S. Line

330 Ft. from E. Line

_____ Ft. from W. Line

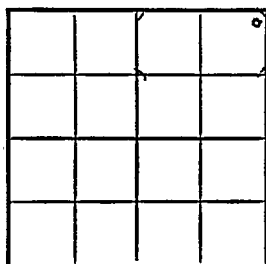

Barton County

Location X

Rig up _____

Drilling and Remarks:

RECORD

Cased _____ in., _____ ft.

Sand _____

Gas _____

Oil _____

Total Depth _____

PRODUCTION

1st 24 hrs. Nat. _____

1st 24 hrs. after shot _____

Gas _____ Cu. Ft.

Dry Hole _____

Abandoned _____

Date

FEB 4 1948

19

S. J. LEWIS

Scout

Map No. 82 Sec. 4 Twp. 19 R. 15W

Well No. 1 Rogers

Harbar Drlg. Company

ABANDONED

Contractor

NE/C

E. 1, 1958
SECTION PLAT

330 Ft. from N. Line

_____ Ft. from S. Line

330 Ft. from E. Line

_____ Ft. from W. Line

			4

Barton County

Location _____

Rig up _____

Drilling and Remarks:

Reagan 522

RECORD

Cased _____ in., _____ ft.

Sand _____

Gas _____

Oil _____

Total Depth 3566

PRODUCTION

1st 24 hrs. Nat. _____

1st 24 hrs. after shot _____

Gas _____ Cu. Ft.

Dry Hole _____

Abandoned _____

Date

APR 7 1948 19

S. J. LEWIS Scout