


Section 4 Township 19 Range 15WWell No. #1 SaylorCompany Grant Oil

NORTH

WEST

EAST

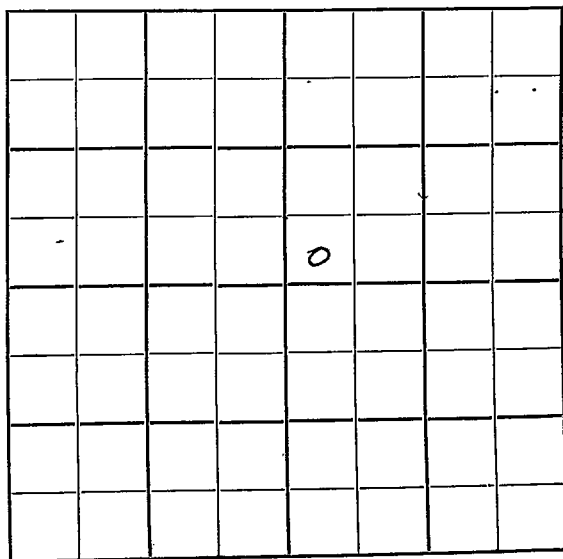

SOUTH

Barton

KANSAS

Sec. 4 Twp. 19 R. 15W

Well No. #1 Saylor Farm

Grant Oil Company

Malloonee Drlg.- Contr. Contractor

Albert Pool


 Ft. from N. Line

330' Ft. from S. Line

 Ft. from E. Line

330' Ft. from W. Line

SW SW NE

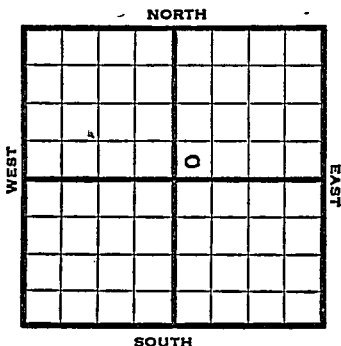

1951 Elev. 1975' REPORT

10/23

Spud 10-23-51
Drlg. 60'

12/5

Spud 10-23-51
Gas well TD 3602
8" @ 958
Anhy 950 Br. Li 3248
Lans. 3261 Cong. 3526
Regan 3553
TD 3583
5" @ 3564 TD 3600
Perf/ 3564-83 Hydrafrac
DD 3602
Comp. 4,200,000 gas

COMPLETED

County Barton State KansasSec. 4 (Blk.) 19 (Sur.) 15W Map No.Operator Grant OilWell No. 1 Farm SaylorElev. Location SW SW NE

FIRST REPORT

330 Ft. From S Line NE330 Ft. From W Line Quarter1st. Report OCT 24 1951

Completion

Remarks

Mallonee Drlg. - Centr.Spudding Date 10-23-51Drlg. Data Albert Pooldrlg. 60'

J. E. TYRA

J. E. TYRA