


KANSAS

Barton

Section 4 Township 19 Range 13-WWell No. #1 Gordon-BirzerCompany E.H. Adair

NORTH

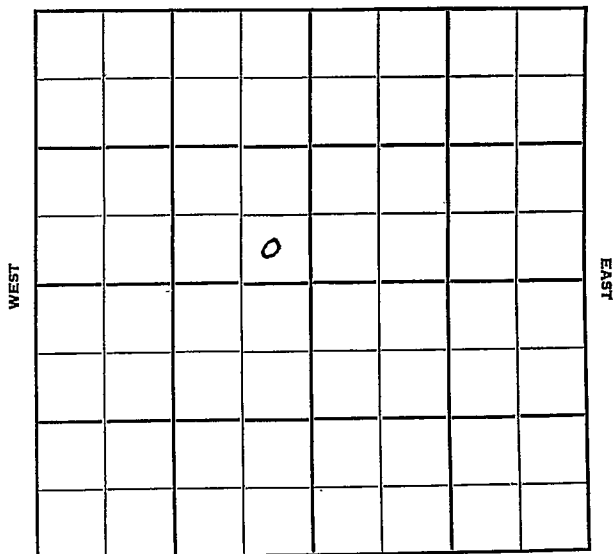

SOUTH

Barton
19

KANSAS

13W

Sec. 4 Twp. 19 R. 13W

Well No. #1 Gordon-Birzer Farm

E. H. Adair Company

Contractor

Wildcat


 Ft. from N. Line

330' Ft. from S. Line

330' Ft. from E. Line

 Ft. from W. Line

SE SE NW

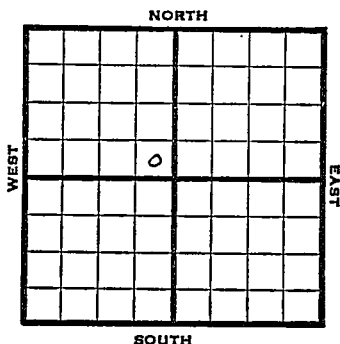

1950

Elev. 1876' REPORT

12/27

Spud 12-21-50
8-5/8" @ 555'
WOC


1951

1/10

Spud 12-21-50
D&A TD 3444
8-5/8" @ 555' Top. 2818
Heeb. 3062 Br Lime 3151
Lans. 3165 Cong. 3391
Arb. 3429-44 TD D&A

ABANDONED

County Barton State Kansas
 Sec. 4 (Blk.) 19 (Sur.) 13W Map No.
 Operator E. H/ Adair
 Well No. 1 Farm Gordon-Birzer
 Elev. _____ Location SE SE NW

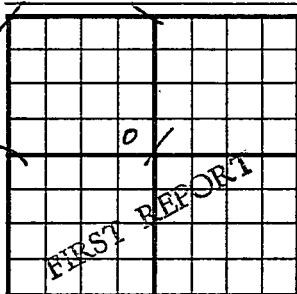


330 Ft. From S Line NW
330 Ft. From E Line Quarter
 1st. Report DEC 27 1950
 Completion _____
 Remarks _____

Spudding Date 12-21-50

Drig. Data Wildcat

8 5/8" @ 555 WOC

J. E. TYRA

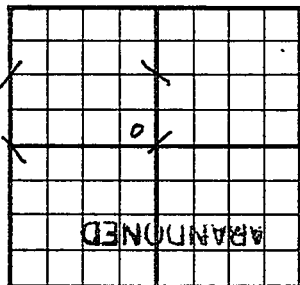County Barton State KansasSec. 4 (^{Blk.}_{Twp.}) 19 (^{Sur.}_{Rge.}) 13W Map No.Operator E. H. AdairWell No. 1 Farm Gordon-BirzerElev. 1876 Location SE SE NW330 Ft. From S Line NW330 Ft. From E Line Quarter

1st. Report

Completion JAN 10 1951Remarks WildcatSpudding Date 12-21-50Drlg. Data D & A TD 34448 5/8" @ 555 Top. 2818 Heeb. 3062Br. lime 3151 Lans. 3165 Cong. 3391Arb. 3429-44 TD D & A