
O.W.W.O.

FORM 31 25M 8-50 WESTERN Barton KANSAS

Section 4 Township 19 Range 15 W

Well No. #1 Schulty (C) (Schultz)

Company W. J. Coppinger

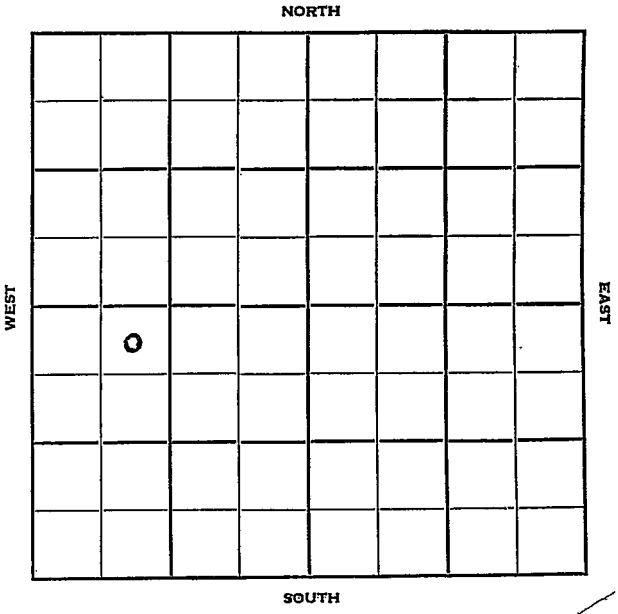

12

FORM 252-B
10M 10-50 PETROL

Barton O.W.W.O. KANSAS

Sec. 4 Twp. 19 R. 15W

Well No. #1 Schulty (C) Farm

W. J. Coppinger Company

Contractor

OTIS-ALBERT POOL


330 Ft. from N. Line

Ft. from S. Line

Ft. from E. Line

990 Ft. from W. Line

NE NW SW

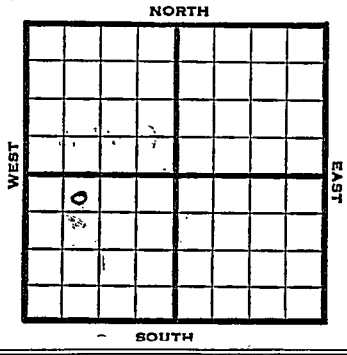

1952	Elev. 1992' REPORT
4/2	MIR
4/9	8" @ 298 Anhy 980 Drlg. 1400'
4/23	Spud 4-4-52 D&A TD 3661' 8" @ 298' Anhy 980 Br Lm 3282 Lans. 3292 DST 3588-95 open 1 hr. rec. 43' gcm DST 3599-3610 open 1 hr. rec. 2700' gas 65' gcm Arb. 3599 Regan 3615 DST 3615-30 open 1 hr. rec. 900' gas 120' o & gcm DST 3615-32 open 1 hr. rec. 500' gas 185' O&GCM TD 3661' D&A
	ABANDONED
1954	O.W.W.O.
7/14	OTD 3661' Anhy 980', KC 3292', Arb. 3599', Reagan 3615' MIRT

OVER

O.W.W.O.

1954
8/25 Oil Well
TD 3661'
OTD 3661'
anhy 980', KC 3292', Arb. 3599',
Reagan 3615'
CO to 3651'
52/3617-30, frac
S/15 boph 12 hrs.
P/10 bo 90 bw
P/44 bo 48 bw
Comp.

COMPLETED

FORM 275 FOR SALE BY KANSAS BLUE PRINT CO.


County Barton State Kansas

Sec. 4 (Blk. / Twp.) 19 (Sur. / Rge.) 15W Map No.

Operator W. J. Coppinger

Well No. 1 Farm Schulty (C)

Elev. Location NE NW SW

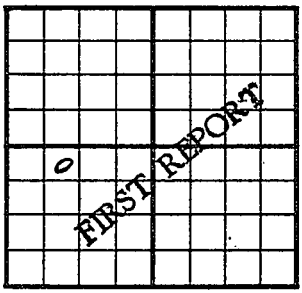

330 Ft. From N Line SW

990 Ft. From W Line Quarter

1st. Report APR 2 1952

Completion

Remarks

Spudding Date

Drlg. Data

MIR

J. G. McGEHEE

Form 26 200 Bks. 11-49 Petrol Barton Kansas

Map No. Sec. 4 Twp. 19 R. 15W

Well No. 2 Schulty (C)

W. J. Coppinger Company

CORRECTION Contractor

NE NW SW


330 Ft. from N. Line

Ft. from S. Line

Ft. from E. Line

990 Ft. from W. Line

SECTION PLAT

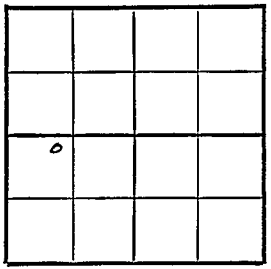

Location

Rig up

Drilling and Remarks:

Reported # 1

RECORD

Cased in., ft.

Sand

Gas

Oil

Total Depth

PRODUCTION

1st 24 hrs. Nat.

1st 24 hrs. after shot

Gas Cu. Ft.

Dry Hole

Abandoned

Date

APR 9 1950 19

J. G. McGEHEE Scout

FORM 275 FOR SALE BY KANSAS BLUE PRINT CO


County Barton State Kansas

Sec. 4 (Blk. Twp.) 19 (Sur. Rge.) 15W Map No.

Operator W. J. Coppinger

Well No. 2 Farm Schulty "C"

Elev. 1992 Location NE NW SW

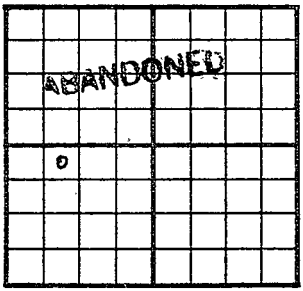

330 Ft. From N Line SW

990 Ft. From W Line Quarter

1st. Report

Completion APR 23 1952

Remarks

Spudding Date 4-4-52

Drlg. Data D & A TD 3661

8" @ 298 Anhy 980 Br. lime 3282

Lans. 3292 DST 3588-95 open 1 hr.

Rec. 43' gcm DST 3599-3610 open 1 hr.

Rec. 2700' gas 65' gcm Arb. 3599

Regan 3615 DST 3615-30 open 1 hr.

Rec. 900' gas 120' o & gcm DST 3615-32

open 1 hr. Rec. 500' gas 185' o & gcm

TD 3661

D & A

J. G. McGEHEE

FORM 275 FOR SALE BY KANSAS BLUE PRINT CO.

O.W.W.O.


County Barton State Kansas

Sec. 4 (Blk. Twp.) 19 (Sur. Rge.) 15W Map No.

Operator W. J. Coppinger

Well No. 1 Farm Schultz "C"

Elev. Location NE NW SW

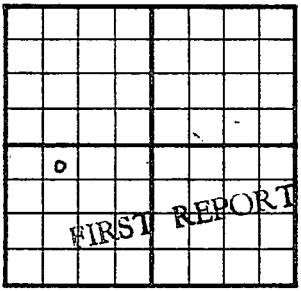

330 Ft. From N Line SW

990 Ft. From W Line Quarter

1st. Report JUL 14 1954

Completion

Remarks OWWO O.W.W.O.

Spudding Date

Drlg. Data Otis-Albert Pool

OTD 3661 Anhy 980 KC 3292 Arb. 3599

Reagan 3615 MIRT

J. G. McGEHEE

FORM 275 FOR SALE BY KANSAS BLUE PRINT CO.

O.W.W.O.


County Barton State Kansas

Sec. 4 (Blk. Twp.) 19 (Sur. Rge.) 15W Map No.

Operator W. J. Coppinger

Well No. 1 Farm Schultz "C"

Elev. Location NE NW SW

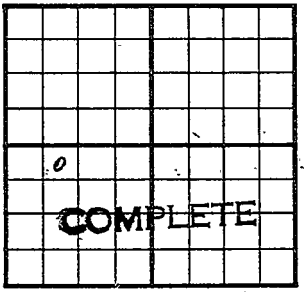

330 Ft. From N Line SW

990 Ft. From W Line Quarter

1st. Report

Completion AUG 25 1954

Remarks OWWO

O.W.W.O.

Spudding Date

Drlg. Data Oil well TD 3661

OTD 3661 Anhy 980 KC 3292 Arb. 3599

Reagan 3615 CO to 3651 52/ 3617-30

frac S/ 15 boph 12 hr. P/ 10 bo 90 bw

P/ 44 bo 48 bw Comp.

FABEN GILSTRAP