

Company Coppinger Drlg.

WEST

EAST

SOUTH

12

Barton KANSAS

SEC.	TWP.	R.
4	19	15W ✓

WELL NO.

3 Schultz "C"

FARM

COMPANY

Coppinger Drlg.

CONTRACTOR

Coppinger


Otis-Albert Pool

990 Ft. from N. Line

Ft. from S. Line

Ft. from E. Line

990 Ft. from W. Line

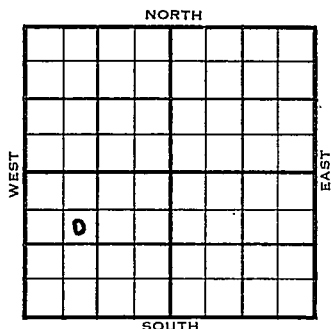


SE NW SW

	ELEVATION	REPORT
1954	1980'	
1/20	Spud 1-17-54 8" @ 233', WOC	
1/27 2/3	Drlg. 2790' Lans 3278', Cong 3554', Reagan 3565', DST 3566-74', 1 hr., 35' gcm, 620# DST 3574-87', 1 hr., 45' m o & gc, 140' oil, 48' wtr, 680# RTD3587' 5" @ 3574'	
2/10	CO 3587 F/1/2 BOPH Est 1 1/2 M gas. S/30 BO 22 hrs. Est 2 1/2 M gas. Sd-frac	
2/17	Spud 1-17-54 Oil Well TD 3587' 8" @ 233' Lans 3278', Cong 3554', Regan 3565' DST 3566-74', opn 1 hr., rec. 35' gcm, 620# DST 3574-87', opn 1 hr., rec. 45' g & ocm, 140' oil, 48' wtr, 680# TD 3587' 5" @ 3574', CO to 3587 F/1/2 boph 1 1/2 mcfg, S/30 bo 22 hrs. 2 1/2 mcfg, Sd-frac, S/6 1/2 boph, S/42 bo 9 hrs. Comp. 150 bopd	

1 C McCFHEE

County Barton State Kansas
 Sec. 4 (Blk. 19 (Sur. 15W Map No.)
 (Twp.) (Rge.)
 Operator Coppinger Drlg.
 Well No. 3 Farm. Schultz "C"
 Elev. 1980 Location SE NW SW

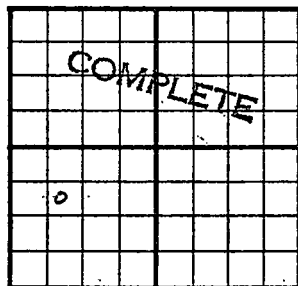

990Ft. From N Line SW
 990Ft. From W Line Quarter

1st. Report FEB 17 1954
 Completion
 Remarks Otis-Albert Pool
Coppinger - Contr.
 Spudding Date 1-17-54

Drlg. Data Oil well TD 3587
8" @ 233 Lans. 3278 Cong. 3554
Regan 3565 -DST 3566-74 open 1 hr.
Rec. 35' gcm 620# DST 3574-87
open 1 hr. Rec. 45' g & ocm 140' oil
48' wtr. 680# TD 3587 5" @ 3574
CO to 3587 F/ $\frac{1}{2}$ boph $1\frac{1}{2}$ mcf/g
S/ 30 bo 2.2 hr. $2\frac{1}{2}$ mcf/g sd-frac
S/ $6\frac{1}{2}$ boph S/ 42 bo 9 hr.
Comp. 150 bopd

J. G. McGEHEE