

Barton KANSAS

DX 78-1

Section 4 Township 19 Range 15W

Well No. 4 Schultz "C"

Company W. J. Coppinger

NORTH

WEST

0							

EAST

SOUTH

12

Barton KANSAS


SEC.	TWP.	R.
4	19	15W

WELL NO. 4 Schültz "C" FARM

COMPANY W. J. Coppinger

CONTRACTOR Coppinger
Otis Albert Pool

330 Ft. from N. Line
Ft. from S. Line
Ft. from E. Line
330 Ft. from W. Line

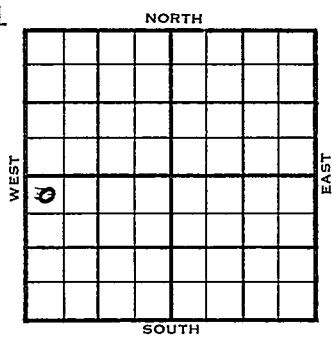

NW NW SW

	ELEVATION	REPORT
1954	1981'	

7/21 Spdg 7-18-54
8" @ 253
WOC

9/1 Spud 7-18-54
Oil Well
TD 3574'
8" @ 253'
Reagan 3563'
TD 3568'
5" @ 3565'
DD 3574'
15 gal free oilph frac.
S/ 2 boph S/ 14 boph
Comp 25 bopd.

COMPLETED

County Barton State Kansas

Sec. 4 (Blk. Twp.) 19 (Sur. Rge.) 15W Map No.

Operator W. J. Coppinger

Well No. 4 Farm Schultz "C"

Elev. _____ Location NW NW SW

330 Ft. From N Line SW

330 Ft. From W Line Quarter

Ist. Report JUL 21 1954

Completion _____

Remarks _____

Coppinger - Contr.

Spudding Date 7-18-54

Drig. Data Otis Albert Pool

8" @ 253 WOC

