
FORM 51 Barton KANSAS

Section 4 Township 19 Range 15W

Well No. #2 Schulz (Schultz)

Company ~~Coppinger~~

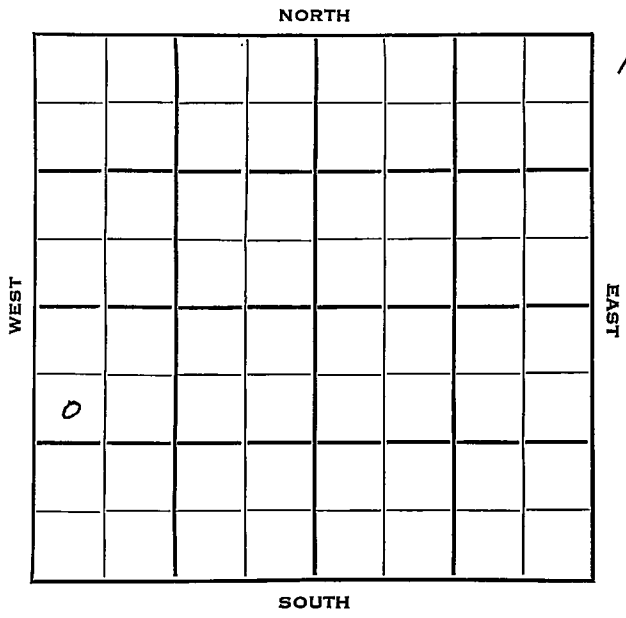

FORM 252-B
10M 8-51 TPCO.

Barton KANSAS

Sec. 4 Twp. 19 R. 15W

Well No. ~~#1 Schulz "C"~~ #2 Schulz "C" Farm

Coppinger Company

Contractor


990 Ft. from N. Line

Ft. from S. Line

Ft. from E. Line

330 Ft. from W. Line

SW NW SW

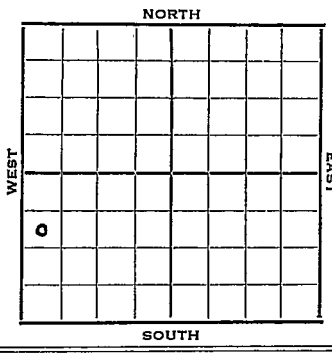

1953 Elev. 1979' REPORT

2/25 Location

3/12 "

3/19 8" @ 220, anhy 960
Drlg. 2260'

3/26 Lans. 3281'
Drlg. 3505'

4/2 BKC 3516, Cong 3552, Reagan 3580
DST 3582-90 1 Hr. 75' O&GCM, 15' muddy oil 640#
RTD 3590
5" @ 3582
CO 3590 s/1½ BOPH

4/9 Oil-frac. S/109 BOPD

4/15 NR

4/22 Spud 3-11-53
Oil Well
TD 3590
8" @ 220
Anhy 960, Lans 3281, B KC 3516, Cong 3552, Regan 3580
DST 3582-90, opn 1 hr., rec. 75' g & ocm, 15' muddy oil, 640#
TD 3590
5" @ 3582, CO to 3590, S/1½ boph
oil-frac, S/109 bopd
Comp. 110 bopd 3% wtr.

COMPLETED

FORM 275 FOR SALE BY KANSAS BLUE PRINT CO.


County Barton State Kansas

Sec. 4 (Blk. Twp.) 19 (Sur. Rge.) 15W Map No.

Operator Coppinger

Well No. 1 Farm Schulz "C"

Elev. Location SW NW SW

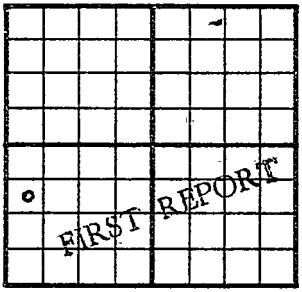

990 Ft. From N Line SW

330 Ft. From W Line Quarter

1st. Report FEB 25 1953

Completion

Remarks

Spudding Date

Drlg. Data

Location

J. G. McGEHEE

FORM 26 200 BKS. 4-52 PETROL

Kansas

Map No. _____ Sec. 4 Twp. 19 R. 15W

Well No. 2 Schulz


Coppinger Company

CORRECTION

_____ Contractor

SW NW SW

SECTION PLAT

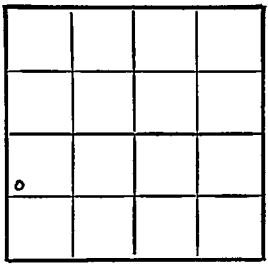

990 Ft. from N. Line

_____ Ft. from S. Line

_____ Ft. from E. Line

330 Ft. from W. Line

Barton County

Location _____

Rig up _____

Drilling and Remarks:

Reported
#1 Schulz "C"

RECORD

Cased _____ in., _____ ft.

Sand _____

Gas _____

Oil _____

Total Depth _____

PRODUCTION

1st 24 hrs. Nat. _____

1st 24 hrs. after shot _____

Gas _____ Cu. Ft.

Dry Hole _____

Abandoned _____

Date

MAR 18 1953 19

J. G. McGEHEE Scout

FORM 275 FOR SALE BY KANSAS BLUE PRINT CO.


County Barton State Kansas

Sec. 4 (Blk. Twp.) 19 (Sur. Rge.) 15W Map No.

Operator Coppinger

Well No. 2 Farm Schulz "C"

Elev. 1979 Location SW NW SW

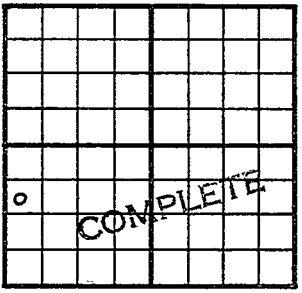

990 Ft. From N Line SW

330 Ft. From W Line Quarter

1st. Report

Completion APR 22 1953

Remarks

Spudding Date 3-11-53

Drlg. Data Oil well TD 3590

8" @ 220 Anhy 960 Lans. 3281

B KC 3516 Cong. 3552 Regan 3580

DST 3582-90 open 1 hr. Rec. 75' g & ocm

15' muddy oil, 640# TD 3590 5" @ 3582

CO to 3590 S/ 1½ boph oil-frac

S/ 109 bopd Comp. 110 bopd 3% wtr.

J. G. McGEHEE