


Section 5 Township 19 Range 12 W

Well No. # 1 Held

Company Shelly-Miller

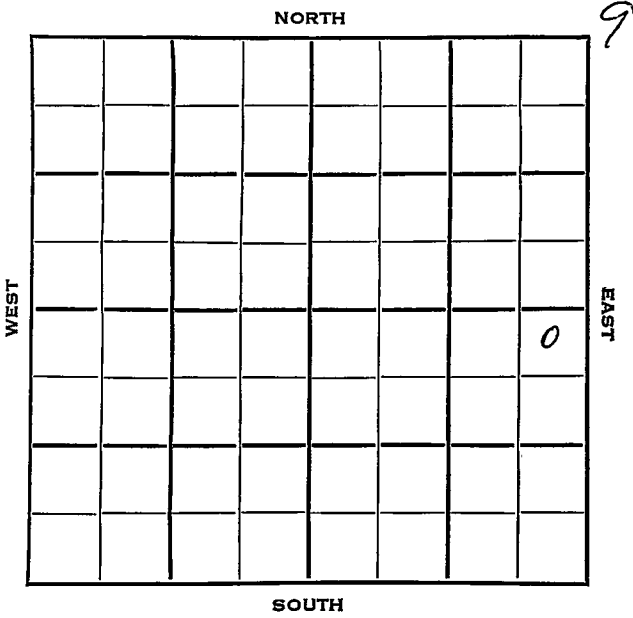

Barton

K 22 543

SEC.	TWP.	R.
5	19	12 W ✓

WELL NO.

1 Held

FARM

COMPANY

Shelly-Miller

CONTRACTOR

Shelly Miller
Wildcat


330 Ft. from N. Line

Ft. from S. Line

330 Ft. from E. Line

Ft. from W. Line

NE NE SE

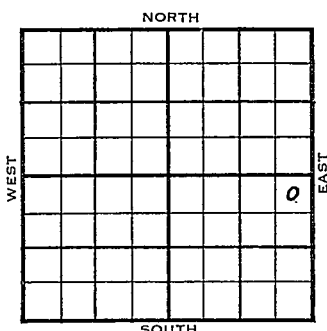


Carter - Ac. Sunray & Texas - DHM

	ELEVATION	REPORT
1954	1804'	
5/12	Spud 5-5-54 8" @ 170 Anhy 631 Drlg. 2930'	
5/19	Heeb 2986 Br li 3093 Lans 3107 DST 3110-85, 1 hr, 120' gas, 60' VSOCM 620# DST 3250-90, 1 hr, 1000' gas, 240' O & GCM 480# Cong. 3367' Arb. 3379 DST 3366-83, 1/2 hr, 8' M RTD 3420 5" @ 3350 Schl	
6/2	Spud 5-5-54 D & A TD 3420 8" @ 170 Anhy 631 Heeb 2986 Br. lime 3093 Lans 3107 DST 3110-85 open 1 hr rec 120' gas, 60' VSOCM 620# DST 3250-90 open 1 hr rec 1000' gas, 240' O & GCM 480# Cong. 3367 Arb. 3379 DST 3366-83 open 1/2 hr rec 8' mud O# TD 3420 5" @ 3350 CO to-3324 12/3301-05 500 A S/16 GW 1 hr. SP 3290 12/3280-84 18/3269-75 S/7 GO 1 GW 1 hr. 1000 A S/4 1/2 BF 1 hr. SP 3206 12/3174-78 1000 A S/19 BF 1 hr. S/15 BF 5 hr. 50% wtr. PB 3150 12/3133-37 1000 A 2 1/2 BW 1/2 hr. D & A	

DX-78

ABANDONED


County Barton State Kansas
 Sec. 5 (Blk.) 19 (Sur.) 12W Map No.
 Operator Shelly-Miller
 Well No. 1 Farm Held
 Elev. Location NE NE SE

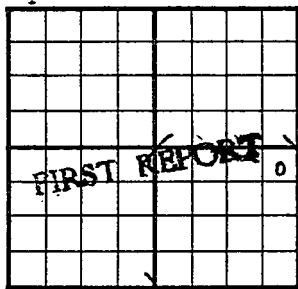

330 Ft. From N Line SE
330 Ft. From E Line Quarter
 Ist. Report MAY 12 1954
 Completion
 Remarks Carter - AC
Sunray & Texas-DM
Shelly-Miller - Contr.
 Spudding Date 5-5-54

Drlg. Data Wildcat
8" @ 170 Anhy 631 drlg. 2930

County Barton State Kansas
 Sec. 5 (Blk.) 19 (Sur.) 12W Map No. 1
 Operator Shelly-Miller
 Well No. 1 Farm Held
 Elev. 1804 Location NE NE SE

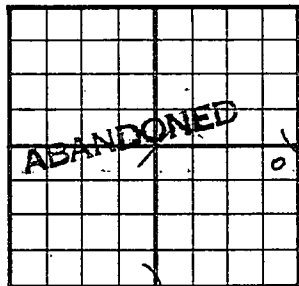

330 Ft. From N Line SE
330 Ft. From E Line Quarter
 Ist. Report
 Completion JUN 2 1954
 Remarks Wildcat
Shelly-Miller - Contr.
 Spudding Date 5-5-54

Drlg. Data D & A TD 3420
8" @ 170 Anhy 631 Heeb. 2986
Br. lime 3093 Lans. 3107 DST 3110-85
open 1 hr. Rec. 120' gas 60' vsocm
620# DST 3250-90 open 1 hr. Rec. 1000'
gas 240' o & gcm 480# Cong. 3367
Arb. 3379 DST 3366-83 open $\frac{1}{2}$ hr.
Rec. 8' mud 0# TD 3420 5" @ 3350
CO to 3324 12/ 3301-05. 500 A
S/ 16 gw 1 hr. SP 3290 12/ 3280-84
18/ 3269-75 S/ 7 go 1 gw 1 hr. 1000 A
S/ $4\frac{1}{4}$ bf 1 hr. SP 3206 12/ 3174-78
1000 A S/ 19 bf 1 hr. S/ 15 bf 5 hr.
50% wtr. PB 3150 12/ 3133-37 1000 A
 $2\frac{1}{2}$ bw $\frac{1}{2}$ hr.

D & A

J. G. McGEHEE