

Barton KANSAS

DX 78-1

Section 5 Township 19 Range 11W

Well No. 2 Robl

Company N. C. R. A

NORTH

WEST

					0		

EAST

SOUTH

Barton KANSAS

SEC. 5	TWP. 19	R. 11W
-----------	------------	-----------

WELL NO.

2 Robl

FARM

COMPANY

N C R A

CONTRACTOR

Hilton Drlg.


St. Peter Pool

Ft. from N. Line

Ft. from S. Line

Ft. from E. Line

Ft. from W. Line

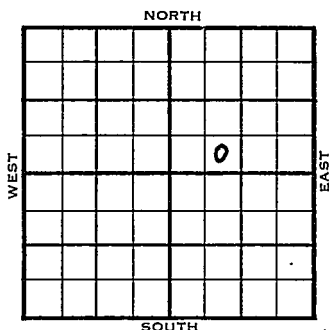

SE SW NE

	ELEVATION	REPORT
1954	1814'	
14/7	Spdg 7-11-54 8" @ 258 Drlg. 980	
7/21	Heeb 2961', Lans 3094'	
8/18	Spud 7-11-54 Oil well TD 3400 8" @ 258 Heeb 2961 Lans 3094 DST 3242-72 open 2 hr rec 70' gas, 20' OCM 0# Cong. 3364 Arb. 3394 DST 3395-3400 open 2 hr rec 150' clean oil, 60' MCO, 90' gas. 800# TD 3400 5" @ 3395 CO to 3400 S/1 BOPH S/5 BOPH 4 hr. Comp. 90 BOPD	

COMPLETED

J. G. McGEHEE

15 1954

Scout Cards	_____
Land Small Map	_____
Land Wall Map	_____
Tracings	_____
France Map	_____
Pierce Map	_____
Misc.	_____

Orig. Data

FABEN GILSTRAP

Scout Cards	770
Land Small Map	
Land Wall Map	
France Map	
Pierce Map	
Misc.	

AUG 24 1954
AUG 4 1954

Orig. Data