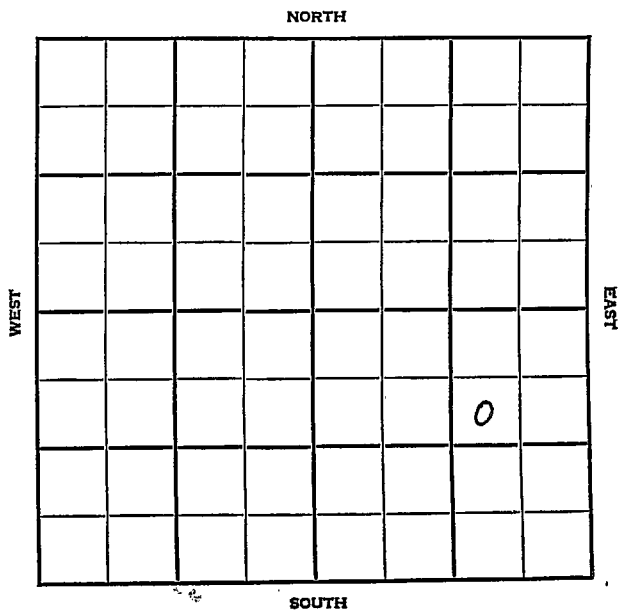


Section 5 Township 19 Range 11 WWell No. #6 SchlochtermeyerCompany Eugene Hubener

Barton

KANSAS

SEC. 5	TWP. - 19	R. 11W
-----------	--------------	-----------

WELL NO.

#6 Schlochtermeyer

FARM

COMPANY

Eugene Hubener

CONTRACTOR


_____ Ft. from N. Line

_____ Ft. from S. Line

_____ Ft. from E. Line

_____ Ft. from W. Line

SW NE SE

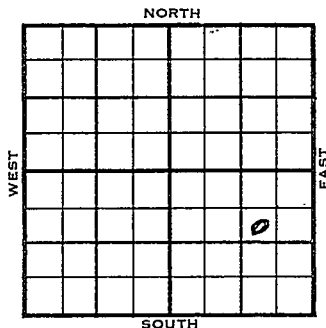

1956

ELEVATION
1803

REPORT

3-7

Comm. 3-2-56
 8" @ 197/125
 Drlg. 1840
 Anh. 607

4-11

DST 3135-62 op 45 min. gas to surface &
 in 4 min. rec. 2000' fluid, 810/15"
 5 1/2" @ 3378
 DD 3385
 S/ 2 boph, 500 A, 1000 A,
 S/ 7 boph, 2 hrs.
 S/ 5 boph, 4 hrs.
 P/ 42 bopd,
 Comp. 28 bopd
 H. 2945
 BL. 3062
 L. 3079
 C. 3353
 A. 3377
 TD 3381

COMPLETED

County Barton Elev. _____
 Sec. 5 Twp. 19 Rge. 11W
 Company Eugene Hubener
 Farm Name Schlochtermeier No. 6

TOPS	DEPTH	LOG	DATUM	Loc. in Sec.
Anh.	607			SW NE SE
TP.				
H.				
Tr.				
Dg.				
BL.				
L.				
K.C.				Geol. _____
B.K.C.				Contr. _____
Ce.				
C.				
M.				
M.				Pool _____
K.				
Mz.				
Mo.				
V.				
S.				
S.				
A.				
R.				
Pe.				
G.				
T.D.				

FIRST REPORT
 MAR 7 '56

Date Comm. 3-2-56
8" @ 197/125 d rlg. 1840

[Handwritten signature/initials]

1

MAR 13 1956

R. G.

County Barton Elev. 1803
 Sec. 5 Twp. 19 Rge. 11W
 Company Eugene Hubener
 Farm Name Schlochtermeyer No. 6

TOPS	DEPTH	LOG	DATUM
------	-------	-----	-------

Anh.	607		
Tr.			
H.	2945		
Tr.			
Dg.			
BL.	3062		1259
L.	3079		1272
K.C.			
B.K.C.			
Ce.			
C.	3353		1550
M.			
M.			
K.			
Mz.			
Mq.			
V.			
S.			
S.			
A.	3377		1574
R.			
Pe.			
G.			
T.D.	3381		

Loc. in Sec. SW NE SE

Geol.

Contr.

Pool

Date Comm. 3-2-56 APR 1 1 1956

8" @ 197/125 DST 3135-62 open 45 min.

gas to surface in 4 min. rec. 2000' fluid

810/15" 5 $\frac{1}{2}$ " @ 3378 DD 3385

S/ 2 boph 500 A 1000 A S/ 7 boph

2 hr. S/ 5 boph 4 hr. P/ 42 bopd

Comp. 28 bopd

APR 19 1956

R. G.