


KANSAS

Barton County

Section 5 Township 19 Range 11W

Well No. #1 Ernsting

Company Tom Allen et al

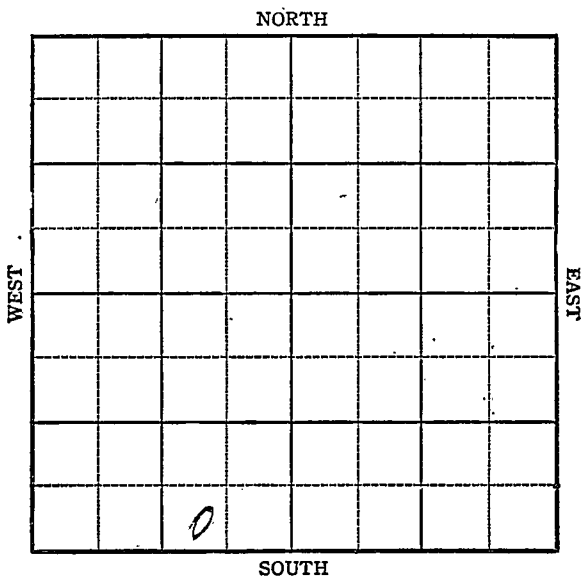

Sec. 5 Twp. 19 R. 11W

Well No. #1 Ernsting Farm

Tom Allen et al Company


St. Peter & Paul

 Ft. from N. Line

330 Ft. from S. Line

990 Ft. from E. Line

 Ft. from W. Line

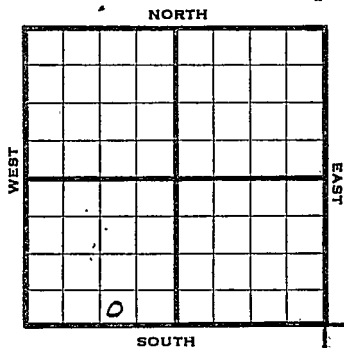

SW SE SW

1945

R E P O R T

1/17 8" 193 '
Anhy. 618
Drlg. 2330


1/31 ?Arb. 3394
5" @ 3396 '
TD 3434 '

ABANDONED

Pool Name St. Peter & Paul**KANSAS**Map No. _____ Sec. 5 Twp. 19 R. 11WWell No. 1 ErnstingTom Allen et al CompanyFIRST REPORT Contractor

SW SE SW

SECTION PLAT

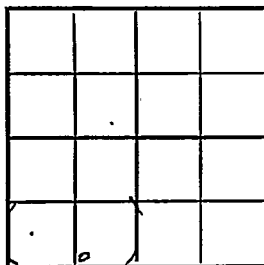

_____ Ft. from N. Line

330 Ft. from S. Line990 Ft. from E. Line

_____ Ft. from W. Line

Barton

Location _____

Rig up _____

Drilling and Remarks:

8"-193anhy 6182330*Hot file*

RECORD

Cased _____ in., _____ ft.

Sand _____

Gas _____

Oil _____

Total Depth _____

PRODUCTION

1st 24 hrs. Nat. _____

1st 24 hrs. after shot _____

Gas _____ Cu. Ft.

Dry Hole _____

Abandoned _____

Date

JAN 17 1945

19

S. J. LEWIS Scout

Small Maps	LC
Tracing	AB
France Map	
Scarborough Map	LC
Moody Map	
Geological Dept.	
Moody Plat Book	

Pool Name St. Peter & PaulMap No. 46 Sec. 5 Twp. 19 R. 11WWell No. 1 ErnstingTom Allan et al CompanyABANDONED Contractor

SW SE SW

SECTION PLAT

	6		

 Ft. from N. Line330 Ft. from S. Line990 Ft. from E. Line Ft. from W. Line

Barton

Location Rig up

Drilling and Remarks:

Q 33945' 3396

RECORD

Cased in., ft.Sand Gas Oil Total Depth 3494

PRODUCTION

1st 24 hrs. Nat. 1st 24 hrs. after shot Gas Cu. Ft.Dry Hole Abandoned

Date

JAN 31 1945

19

S. J. LEWIS

Scout

Misc. Small Maps	LP
Cards	LP
Tracing	LP
France Map	✓
Scarborough Map	LP
Pierce Map	LP
Geological Dept.	
Pierce Flat Book	