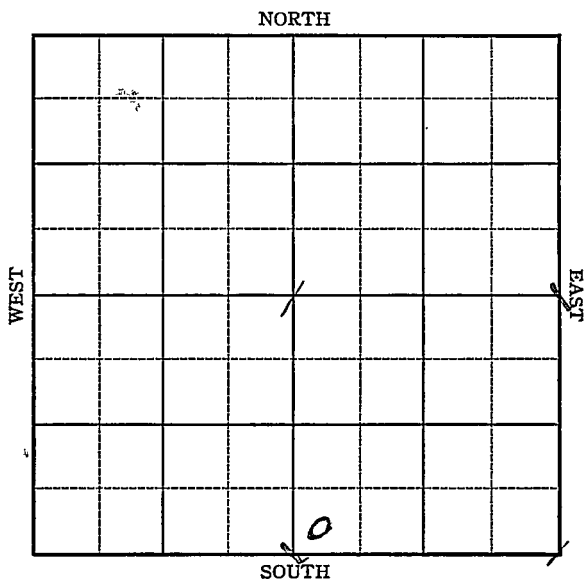


Barton

KANSAS

Section 5 Township 19 Range 11WWell No. #1 SchlochtermeyerCompany C.E. Ash

Sec. 5 Twp. 19 R. 11W

Well No. #1 Schlochtermeyer Farm

C.E. Ash Company

Wildcat


 Ft. from N. Line

330 Ft. from S. Line

 Ft. from E. Line

330 Ft. from W. Line

Elev. 1813

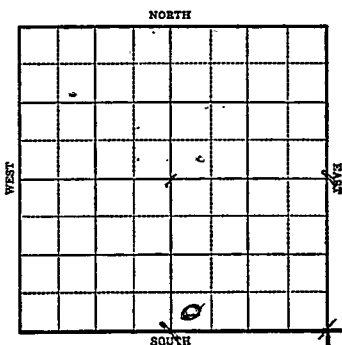

1944

R E P O R T

3/1 Location

3/8 Rptary

3/15 8" @ 192
Anhy 612
Drlg. 1880'

3/22 Drlg. 3153'

3/29 Lans 3090
Arb 3381
TD 3403
5" @ 3385
Rust

4/5 "

4/12 TD 3407
1000' oil 10 qts
2000' oil in 72 hrs.

4/19 " " " "

4/26 " " " "

5/3 " " " "

5/10 " " " "

5/17 " " " "

5/24 Pump 350 oil Temp. Pot.

5/31 " " " " "

OVER

1944

6/7 5" @ 3387
Arb. 3387
TD 3407
Pump 586 Pot.
No Water.
Grav. 39.0

COMPLETED

Barton

KANSAS

Map No. 76 Sec. 5 Twp. 19 R. 11WWell No. 1 SchlochtermeyerC. E. Ash Company

FIRST REPORT Contractor

SW SE

SECTION PLAT

 Ft. from N. Line330 Ft. from S. Line Ft. from E. Line330 Ft. from W. Line*close on
acres*

Wildcat

Location XRig up

Drilling and Remarks:

RECORD

Cased in., ft.Sand Gas Oil Total Depth


PRODUCTION

1st 24 hrs. Nat. 1st 24 hrs. after shot Gas Cu. Ft.Dry Hole Abandoned

Date

MAR 1 1944 19

S. J. LEWIS Scout

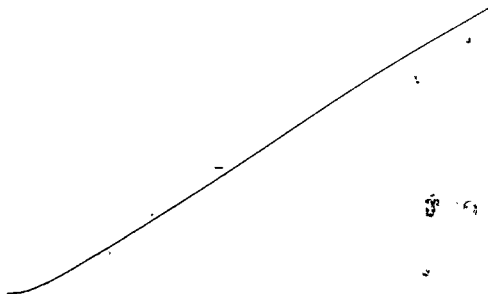

Misc. Small Maps *On a*
Cards *Madge*
Tracing *ME*
France Map *ME*
Scarborough Map *ME*
Moody Map *ME*
Geological Dept.
Moody Plat Book

KANSAS

Pool Name St. PeterMap No. 86 Sec. 5 Twp. 19 R. 11WWell No. 1 SchlochtermeyerC. E. Ash CompanyCOMPLETED Contractor

SW SE

SECTION PLAT

 Ft. from N. Line330 Ft. from S. Line Ft. from E. Line330 Ft. from W. LineBarton CountyLocation Rig up

Drilling and Remarks:

*Ar 8338?**5" @ 338?**Pump 586 P.D.**No Water**29 2/3*

RECORD

Cased in., ft.Sand Gas Oil Total Depth 340?

PRODUCTION

1st 24 hrs. Nat. 1st 24 hrs. after shot Gas Cu. Ft.Dry Hole Abandoned

Date

JUN 7 1944 19S. J. LEWIS Scout

Misc. Small Maps

Cards

Tracing

France Map

Scarborough Map

Moody Map

Geological Dept.

Moody Plat Book