
DX 78-1 Barton KANSAS

Section 5 Township 19 Range 11W

Well No. #5 Schlochtermeyer

Company ~~Francis Oil & Gas et al~~ Huebner Drlg.

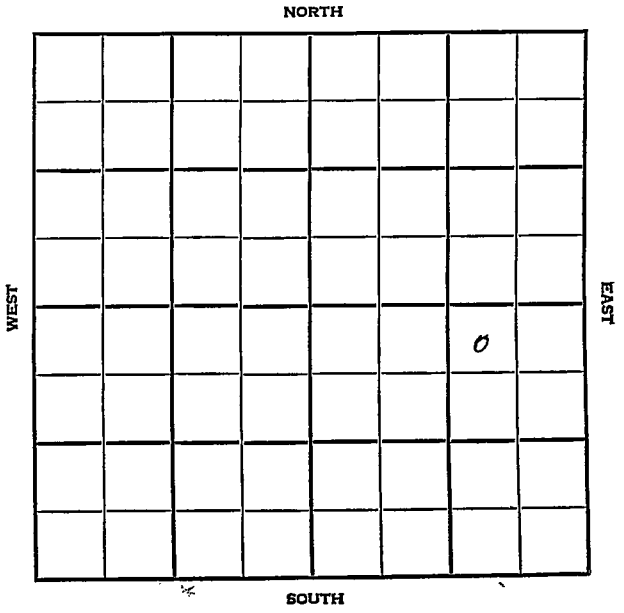

Barton KANSAS

SEC.	TWP.	R.
5	19	11W

WELL NO.

5 Schlochtermeyer FARM

COMPANY

~~Francis Oil & Gas et al~~ HUEBNER DRLG.

CONTRACTOR

St. Peter Pool


330 Ft. from N. Line

Ft. from S. Line

990 Ft. from E. Line

Ft. from W. Line

NW NE SE

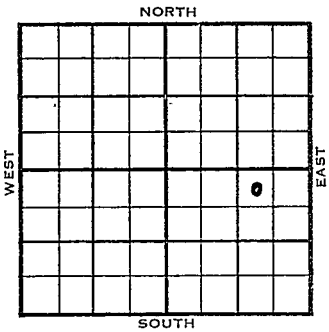

	ELEVATION	REPORT
1954	1815'	
11/17		Spud 11-10-54 8" @ 200' Anhy 608'
1955 1/12		Spud 11-10-54 - Oil Well TD 3404' 8" @ 200' Anhy 608', Heeb. 2960', KC 3095' DST 3110-70', opn 55",rec. 1640' gassy oil, 1000# Arb. 3382' TD 3395' 5" @ 3387' DD 3404' 3 goph 1000A B/½ boph 100A 4½ bo 1 hr. Comp. 25 bopd 31% wtr.

COMPLETED

DX-78

FORM 275 FOR SALE BY KANSAS BLUE PRINT CO.


County Barton State Kansas

Sec. 5 (Blk. / Twp.) 19 (Sur. / Rge.) 11W Map No.

Operator Francis Oil & Gas etal.

Well No. 5 Farm Schlochtermeyer

Elev. 1815 Location NW NE SE

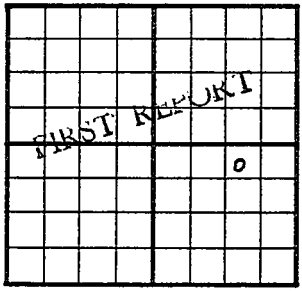

330 Ft. From N Line SE

990 Ft. From E Line Quarter

1st. Report NOV 17 1954

Completion

Remarks


Spudding Date 11-10-54

Drlg. Data St. Peter Pool

8" @ 200 Anhy 608

FABEN GILSTRAP

NOV 18 1954

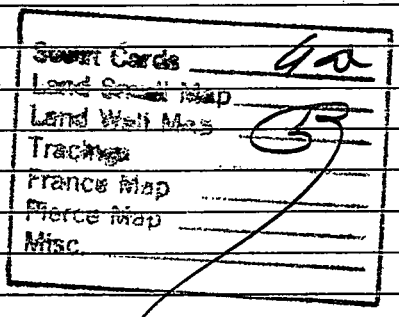

Drlg. Data

FORM 26 200 BKS, 4-52 PETROL

Kansas

Map No. _____ Sec. 5 Twp. 19 R. 11W


Well No. 5 Schlochtermeyer

Huebner Drlg. Company

CORRECTION Contractor

NW NE SE

SECTION PLAT

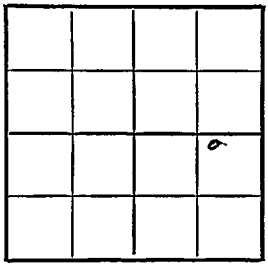

330 Ft. from N. Line

_____ Ft. from S. Line

990 Ft. from E. Line

_____ Ft. from W. Line

Barton County

Location _____

Rig up _____

Drilling and Remarks:

Reported
Francis Oil & Gas

RECORD

Cased _____ in., _____ ft.

Sand _____

Gas _____

Oil _____

Total Depth _____

PRODUCTION

1st 24 hrs. Nat. _____

1st 24 hrs. after shot _____

Gas _____ Cu. Ft.


Dry Hole _____

Abandoned _____

Date

NOV 23 1954 19

FABEN CLOSTRAP Scout

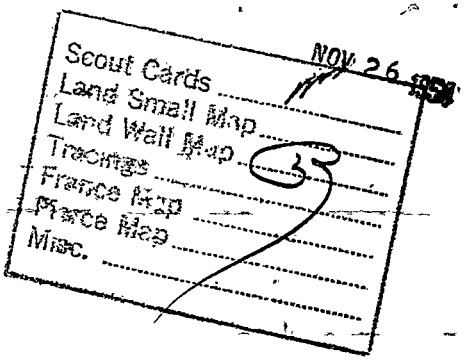
Scout Cards
Land Small Map
Land Wall Map
Tracings
France Map
Pierce Map
Misc.
NOV 26

FORM 275 FOR SALE BY KANSAS BLUE PRINT CO.


County Barton State Kansas

Sec. 5 (Blk. Twp.) 19 (Sur. Rge.) 11W Map No.

Operator Huebner Drlg.

Well No. 5 Farm Schlochtermeyer

Elev. 1815 Location NW NE SE

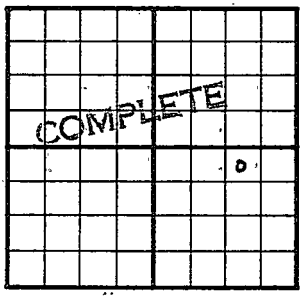

330 Ft. From N Line SE

990 Ft. From E Line Quarter

1st. Report

Completion JAN 1 2 1955

Remarks St. Peter Pool

Spudding Date 11-10-54

Drlg. Data Oil well TD 3404

8" @ 200 Anhy 608 Heeb. 2960

KC 3095 DST 3110-70 open 55 min.

Rec. 1640' gassy oil 1000# Arb. 3382

TD 3395 5" @ 3387 DD 3404 3 goph

1000 A B/ $\frac{1}{2}$ boph 100 A $4\frac{1}{2}$ bo 1 hr.

Comp. 25 bopd 31% wtr.

FABEN GILSTRAP

7 1
3 1

JAN 18 1955

Scout Cards
Land Small Map
Land Trail Map
Tracings
Franke Map
Pierce Map
Misc.

Dtlg. Data