FORM 51 10M 7-48 PETROL

KANSAS


Rice

Section 5 Township 19 Range 10W

Well No. 1 Monney

Company Eldorado Ref et al

Silica Pool

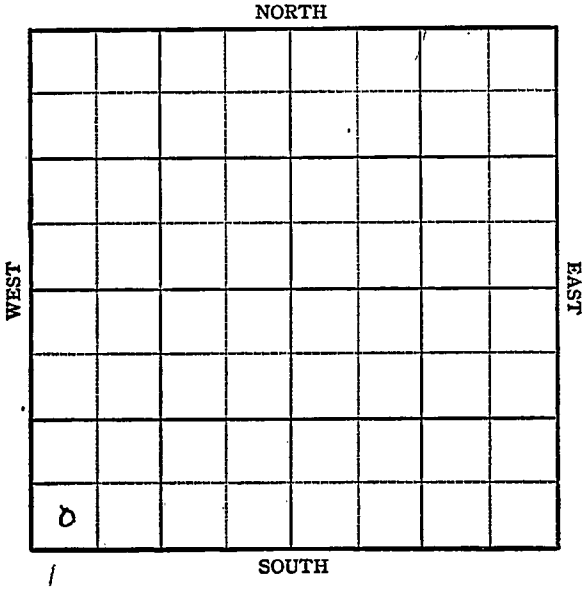

FORM 252-A
5M 10-48 PETROL


KANSAS Rice

Sec. 5 Twp. 19 R. 10W

Well No. #1 Mooney Farm

Eldorado Ref. et al Company

Silica Pool

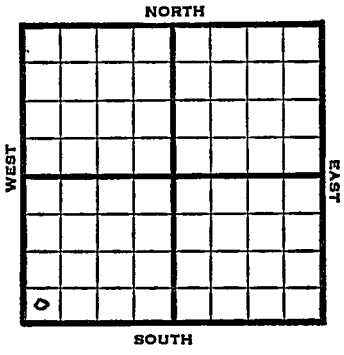

_____ Ft. from N. Line

330' Ft. from S. Line

_____ Ft. from E. Line

330' Ft. from W. Line

SW/C

1948	Eli 1760' REPORT
10/27	RUR
11/3	8" @ 163' Drlg. 2050'
11/10	TD 3375' Lans. 3003' Arb. 3345' Aband.

ABANDONED.

Form 26 200 Bks. 9-48 Petrol

Kansas

Silica Pool

Map No. _____ Sec. 5 Twp. 19 R. 10W

Well No. 1 Mooney

Eldorado Ref. etal. Company

FIRST REPORT Contractor

SW/C


_____ Ft. from N. Line

330 Ft. from S. Line

_____ Ft. from E. Line

330 Ft. from W. Line

SECTION PLAT

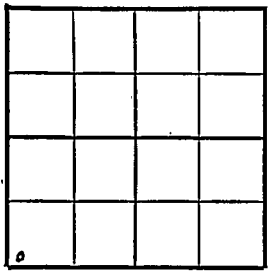

Rice County

Location

Rig up

Drilling and Remarks:

R U R

RECORD

Cased _____ in., _____ ft.

Sand

Gas

Oil

Total Depth

PRODUCTION

1st 24 hrs. Nat.

1st 24 hrs. after shot

Gas _____ Cu. Ft.

Dry Hole

Abandoned

Date

OCT 27 1948 19

S. J. LEWIS Scout

Form 26 200 Bks. 9-48 Petrol

Kansas

Silica Pool

Map No. 46 Sec. 5 Twp. 19 R. 10W

Well No. 1 Mooney


Eldorado Ref. etal. Company

ABANDONED Contractor

SW/C

E 1/1760

SECTION PLAT

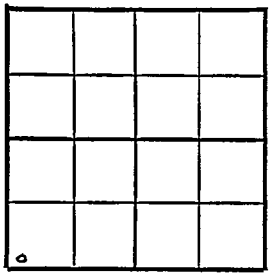

____ Ft. from N. Line

330 Ft. from S. Line

____ Ft. from E. Line

330 Ft. from W. Line

Rice County

Location

Rig up

Drilling and Remarks:

Lans 3003

OA 3345

RECORD

Cased ____ in., ____ ft.

Sand

Gas

Oil

Total Depth 3375

PRODUCTION

1st 24 hrs. Nat.

1st 24 hrs. after shot

Gas ____ Cu. Ft.

Dry Hole

Abandoned

Date

NOV 10 1948 19.

S. J. LEWIS Scout