


Section 5 Township 19 Range 10WWell No. #1 StratmanCompany Lewis Drlg. Co.

NORTH

WEST

EAST

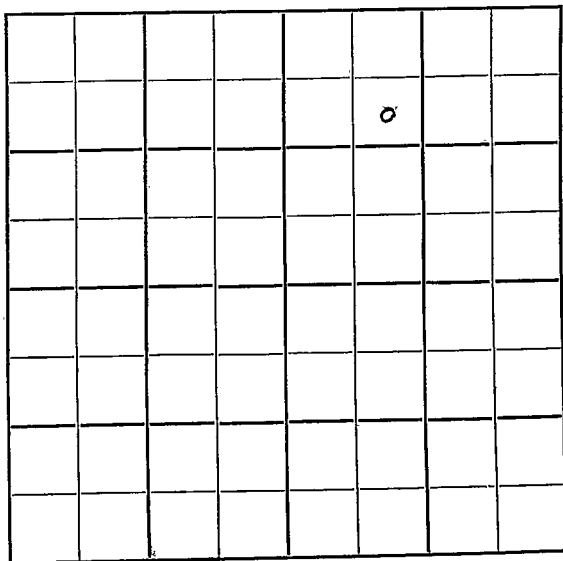

SOUTH

Rice KANSAS ✓

Sec. 5 Twp. 19 R. 10W

Well No. #1 Stratmann Farm

Lewis Drlg. Co. Company

Ringwald Pool


990' Ft. from N. Line

 Ft. from S. Line

 Ft. from E. Line

990'
 Ft. from W. Line

SE NW NE

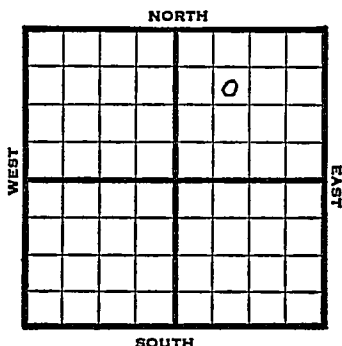

1950

Elev 1741' REPORT

1/4

Location

1/18

TD 3338'

8"@ 160'

Anhy 470-90

Lans 2951'

Heeb 2845'

Brown L 2967'

Lans 2995'

Cong 3308'

D&A

Aband.

ABANDONED

Kansas

Ringwald Pool


Map No. _____ Sec. 5 Twp. 19 R. 10WWell No. 1 Stratmann

_____ Lewis Drlg. Co. _____ Company

_____ Contractor

SE NW NE

SECTION PLAT

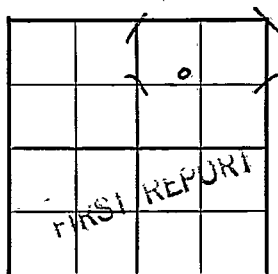990 Ft. from N. Line

_____ Ft. from S. Line

_____ Ft. from E. Line

990 Ft. from W. LineRice CountyLocation X

Rig up _____

Drilling and Remarks:

RECORD

Cased _____ in., _____ ft.

Sand _____

Gas _____

Oil _____

Total Depth _____

PRODUCTION

1st 24 hrs. Nat. _____

1st 24 hrs. after shot _____

Gas _____ Cu. Ft.

Dry Hole _____

Abandoned _____

Date

JAN 4 1950 19JE TYRA Scout


Kansas

Ringwald Pool

Map No. _____ Sec. 5 Twp. 19 R. 10WWell No. 1 StratmanLewis D. Ig. Company

Contractor

SE NW NE

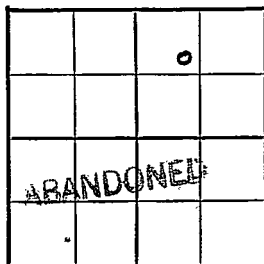E.L. 174/
SECTION PLAT990 Ft. from N. Line Ft. from S. Line Ft. from E. Line990 Ft. from W. Line

Rice County

Location _____

Rig up _____

Drilling and Remarks:

8" @ 160

ank 470-90

Lan 2951

Hub 2845

Brown L. 2967

Lana 2995

Carg. 3308

RECORD

Cased _____ in., _____ ft.

Sand _____

Gas _____

Oil _____

Total Depth 3338

PRODUCTION


Date

D & A.

JAN 18 1950

19

J. E. TYRA Scout