


Section 5 Township 19 Range 2 WWell No. 1 JohnsonCompany Harry Creek et al

NORTH

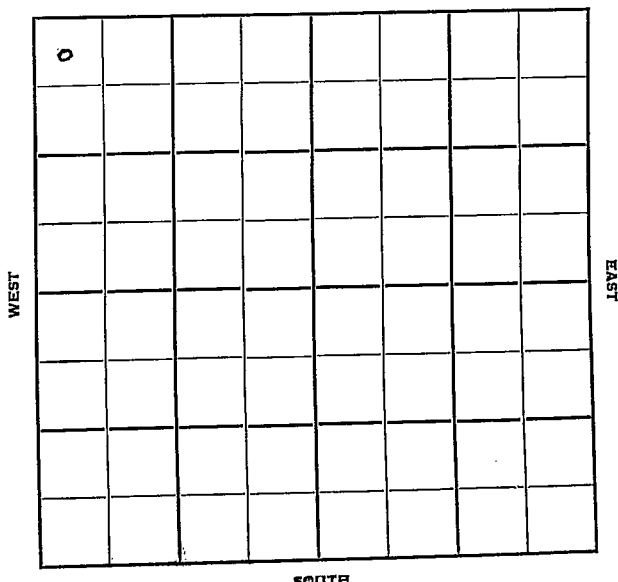

McPherson

KANSAS

Sec. 5 Twp. 19 R. 2W ✓

Well No. #1 Johnson Farm

Harry Creek et al Company

Contractor

Wildcat


330' Ft. from N. Line

     Ft. from S. Line

     Ft. from E. Line

330' Ft. from W. Line

NW NW NW

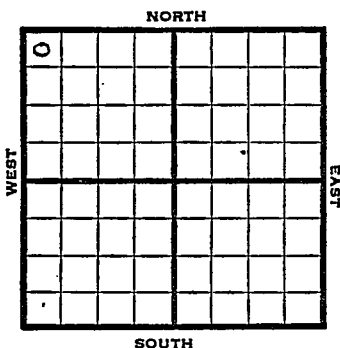

1950

Elev 1550

REPORT

5/3 Rig up

9/20 Spud 5-2-50  
8 5/8" @ 110  
5 1/2" @ 3070  
TD 3070  
10/3000-10  
Miss 3003  
P/all water  
D&A

**ABANDONED**

Kansas

Map No. \_\_\_\_\_ Sec. 5 Twp. 19 R. 2WWell No. 1 JohnsonHarry Creek etal. Company

Contractor

NW NW NW


330 Ft. from N. Line

\_\_\_\_\_ Ft. from S. Line

\_\_\_\_\_ Ft. from E. Line

330 Ft. from W. Line

## SECTION PLAT

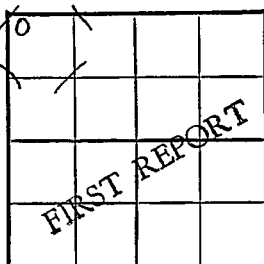

McPherson County

Location \_\_\_\_\_

Rig up X

Drilling and Remarks:

## RECORD

Cased \_\_\_\_\_ in., \_\_\_\_\_ ft.

Sand \_\_\_\_\_

Gas \_\_\_\_\_

Oil \_\_\_\_\_

Total Depth \_\_\_\_\_

## PRODUCTION

1st 24 hrs. Nat. \_\_\_\_\_

1st 24 hrs. after shot \_\_\_\_\_

Gas \_\_\_\_\_ Cu. Ft.

Dry Hole \_\_\_\_\_

Abandoned \_\_\_\_\_

Date

MAY 3 1950


19

J. E. TYRA

Scout

County McPherson State Kansas  
 Sec. 5 (Blk. 19) (Sur. 2W) Map No. \_\_\_\_\_  
 Operator Harry Creek et al.  
 Well No. 1 Farm Johnson

Elev. 1550 Location NW NW NW

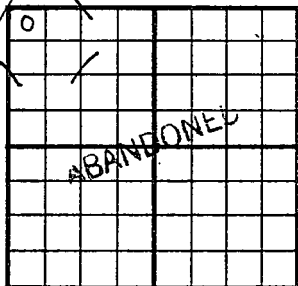

330 Ft. From N Line NW  
330 Ft. From W Line Quarter

Ist. Report ~~SEP 20 1950~~

Completion SEP 20 1950

Remarks \_\_\_\_\_

Wildcat

Spudding Date 5-2-50

Drlg. Data D & A TD 3070

8 5/8" @ 110 5 1/2" @ 3070 TD 3070

10/ 3000-10 Miss. 3003 P/ all water

D & A