
FORM 51 25M 3-49 PETROL

KANSAS Barton

Section 5 Township 19 Range 15-W

Well No. #1 Schultz

Company W J Coppinger

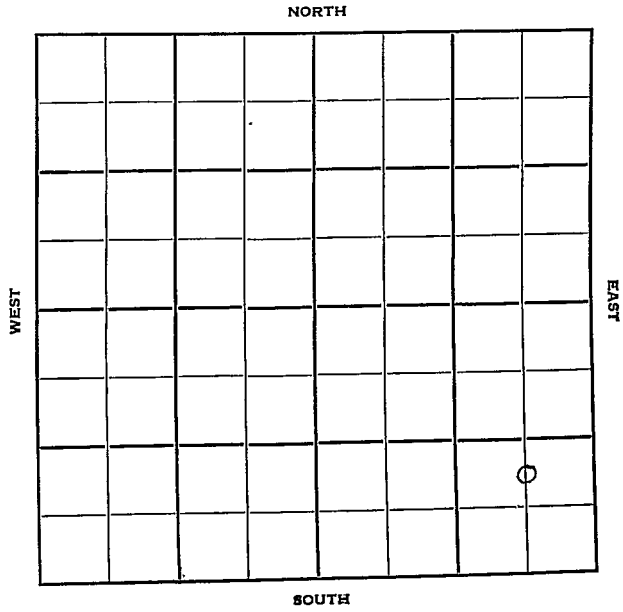

16

FORM 252-B
10M 9-49 PETROL

KANSAS Barton

Sec. 5 Twp. 19 R. 15-W

Well No. #1 Schultz Farm

W J Coppinger Company

Contractor

Albert


Ft. from N. Line

990 Ft. from S. Line

660 Ft. from E. Line

Ft. from W. Line

C N L SE SE

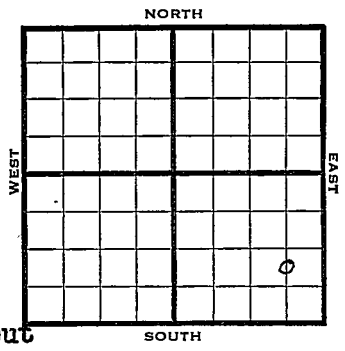

Sunray farmout

	REPORT
1950	Elev 2001
7/12	MIM
8/23	TD 3602 8" @ 990 Amhy 986 Lans 3301 B KC 3509 Cong 3556 Regan 3559 TD 3602 5" @ 3592 F/30 bopd & 2 mcfg Comp 30 bopd 2 mcfg Completed

COMPLETED

Form 26 200 Bks. 11-49 Petrol

Kansas

Albert Pool

Map No. _____ Sec. 5 Twp. 19 R. 15W

Well No. 1 Schultz

W. J. Coppinger Company

_____ Contractor

C N L SE SE


_____ Ft. from N. Line

990 Ft. from S. Line

660 Ft. from E. Line

_____ Ft. from W. Line

SECTION PLAT

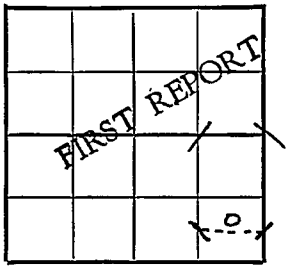

Barton County Sunray farmout

Location _____

Rig up _____

Drilling and Remarks:

M I M

RECORD

Cased _____ in., _____ ft.

Sand _____

Gas _____

Oil _____

Total Depth _____

PRODUCTION

1st 24 hrs. Nat. _____

1st 24 hrs. after shot _____

Gas _____ Cu. Ft.

Dry Hole _____

Abandoned _____

Date

JUL 12 1950 19

J. E. TYRA Scout

FORM 275 FOR SALE BY KANSAS BLUE PRINT CO.


County Barton State Kansas

Sec. 5 (Blk. Twp.) 19 (Sur. Rge.) 15W Map No.

Operator W. J. Coppinger

Well No. 1 Farm Schultz

Elev. 2001 Location C N L SE SE

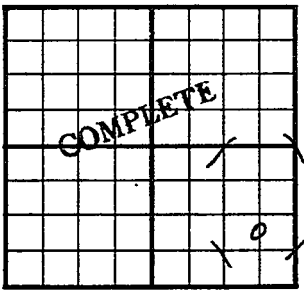

990 Ft. From S Line SE

660 Ft. From E Line Quarter

1st. Report

Completion AUG 23 1950

Remarks

Albert Pool

Spudding Date

Drlg. Data Oil well TD3602

8" @ 990 Anhy 986 Lans. 3301 B KC 3509

Cong. 3556 Regan 3559 TD 3602

5" @ 3592 F/ 30 bopd & 2 mcfg

Comp. 30 bopd 2 mcfg

J. E. TYRA