


Section 5 Township 19 Range 15 W  
Well No. # 6 Schulte (Schultz)  
Company Skelly Oil

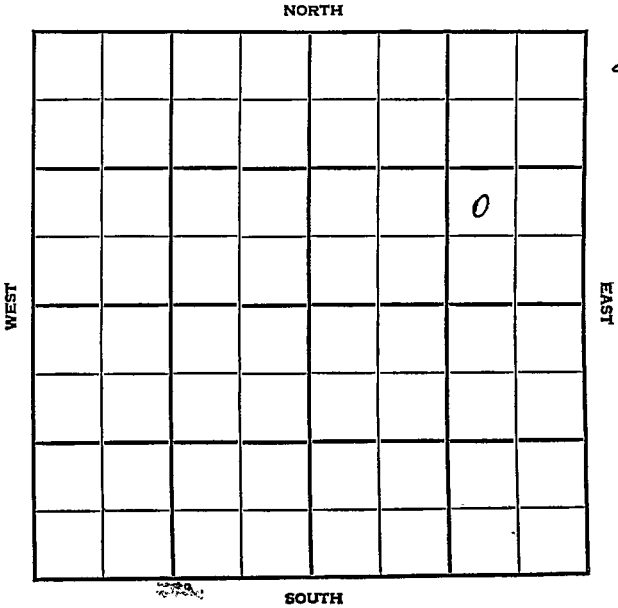

Barton KANSAS

SEC.	TWP.	R.
5	19	15W

WELL NO. 6 Schulte FARM

COMPANY Skelly Oil

CONTRACTOR \_\_\_\_\_


Otis-Albert Pool

\_\_\_\_\_ Ft. from N. Line

990 \_\_\_\_\_ Ft. from S. Line

990 \_\_\_\_\_ Ft. from E. Line

\_\_\_\_\_ Ft. from W. Line

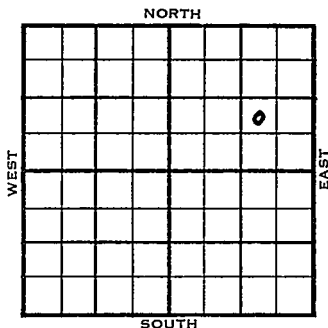

NW SE NE

	ELEVATION	REPORT
1954	2001'	

12/1 Location

1955

1/19

Spud 11-29-54 - Oil Well

TD 3646'

8" @ 989'

Heeb. 3222', Tor. 3234', Doug. 3252',

Br. Lime 3292', Lans 3303', Cong.

3575', Reagan 3586'

TD 3631'

5" @ 3630'

DD 3646'

PB 3624'

30/3617-22, sd-oil-frac

S/31 bo 8 hrs.

PB 3603'

48/3592-3600

S/56 bo 2 bw 14 hrs.

Viso-frac

S/113 BO 6 BW 7 hrs.

DP to 3626'

S/97 BO 8 BW 10 hrs.

Comp. 87 BOPD 1 BW

**COMPLETED**

County **Barton** State **Kansas**

Sec. **5** (Blk. Twp.) **19** (Sur. Rge.) **15W** Map No.

Operator **Skelly Oil**

Well No. **6** Farm **Schulte**

Elev. Location **NW SE NE**

			0
FIRST REPORT			

**990** Ft. From **S** Line **NE**

**990** Ft. From **E** Line Quarter

1st. Report **DEC 1 1954**

Completion

Remarks

Spudding Date

Drlg. Data **Otis-Albert Pool**

**Location**

**FABEN GILSTRAP**

County Barton State Kansas  
 Sec. 5 (Blk. 19) (Sur. 15W) (Twp.) (Rge.) Map No.  
 Operator Skelly Oil  
 Well No. 6 Farm Schultz  
 Elev. 2001 Location NW SE NE


990 Ft. From S Line NE  
990 Ft. From E Line Quarter  
 Ist. Report  
 Completion JAN 1 9 1955  
 Remarks Otis-Albert Pool  
 Spudding Date 11-29-54

Drlg. Data Oil well TD 3646  
8" @ 989 Heeb. 3222 Tor. 3234  
Doug. 3252 Br. lime 3292 Lans. 3303  
Cong. 3575 Reagan 3586 TD 3631  
5" @ 3630 DD 3646 PB 3624 30/ 3617-22  
sd-oil-frac S/ 31 bo 8 hr. PB 3603  
48/ 3592-3600 S/ 56 bo 2 bw 14 hr.  
viso-frac S/ 113 bo 6 bw 7 hr.  
DP to 3626 S/ 97 bo 8 bw 10 hr.  
Comp. 87 bopd 1 bw

FABEN GILSTRAP