


Section 5 Township 19 Range 15W

Well No. #4 Wedel

Company N C R A

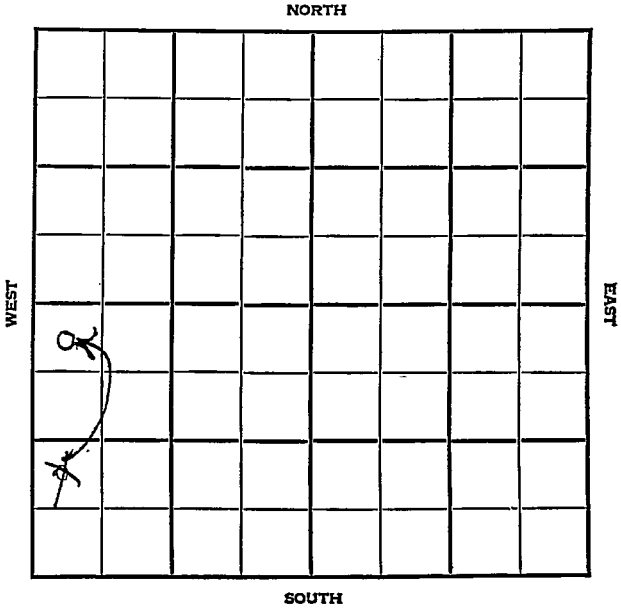

Sec. 5 Twp. 19 R. 15W

Well No. #4 Wedel Farm

N.G.R.A. Company


Albert

330' Ft. from N. Line

~~990~~ Ft. from S. Line

_____ Ft. from E. Line

330 Ft. from W. Line

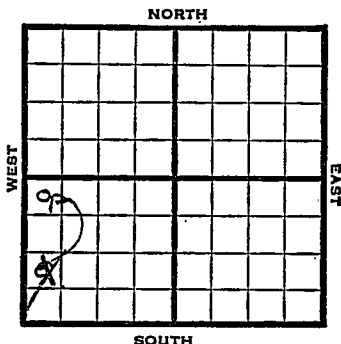

NW NW SW ~~SE~~

1947 Elev. 2063' REPORT

11/19 Location

11/25 "

12/3 Lansing 3354'
Basal 3661'
5" @ 3664'
TD 3682'
2000' oil 2 hrs.

12/10 "

12/30 Basal 3661'
5" @ 3664'
Pump 400 Pot
36.0 Gr.
TD 3687'

COMPLETED

Map No. _____ Sec. 5 Twp. 19 R. 15W

Well No. 4 Wedel

N C R A _____ Company

FIRST REPORT _____ Contractor

NW SW SW

SECTION PLAT

_____ Ft. from N. Line

990 Ft. from S. Line

_____ Ft. from E. Line

330 Ft. from W. Line

		.	
o			

Barton County

Location X

Rig up _____

Drilling and Remarks: _____

RECORD

Cased _____ in., _____ ft.

Sand _____

Gas _____

Oil _____

Total Depth _____

PRODUCTION

1st 24 hrs. Nat. _____

1st 24 hrs. after shot _____

Gas _____ Cu. Ft.

Dry Hole _____

Abandoned _____

Date

NDV 1 9 1947 19

S. J. LEWIS Scout

Map No. 82 Sec. 5 Twp. 19 R. 15W

Well No. 4 Wedel

N C RAA Company

CORRECTION Contractor

NW SW

SECTION PLAT

330 Ft. from N. Line

_____ Ft. from S. Line

_____ Ft. from E. Line

330 Ft. from W. Line

o			

Barton County

Location _____

Rig up _____

Drilling and Remarks:

Reported

NW SW SW

RECORD

Cased _____ in., _____ ft.

Sand _____

Gas _____

Oil _____

Total Depth _____

PRODUCTION

1st 24 hrs. Nat. _____

1st 24 hrs. after shot _____

Gas _____ Cu. Ft.

Dry Hole _____

Abandoned _____

Date

NOV 25 1947 19

S. J. LEWIS Scout

Map No. 82 Sec. 5 Twp. 19 R. 15W

Well No. 4 Wedel

N C R A

Company

COMPLETE

Contractor

NW SW

E12068
SECTION PLAT

330 Ft. from N. Line

_____ Ft. from S. Line

_____ Ft. from E. Line

330 Ft. from W. Line

6			

Barton County

Location _____

Rig up _____

Drilling and Remarks:

Basal. 361
5" @ 3664
Pump 400 P.D.

360/36

RECORD

Cased _____ in., _____ ft.

Sand _____

Gas _____

Oil _____

Total Depth 3657

PRODUCTION

1st 24 hrs. Nat. _____

1st 24 hrs. after shot _____

Gas _____ Cu. Ft.

Dry Hole _____

Abandoned _____

Date

DEC 30 1947 19

S. J. LEWIS

Scout