


Section 6 Township 19 Range 12 W

Well No. # 1 Bales Est.

Company J. H. Tatlock

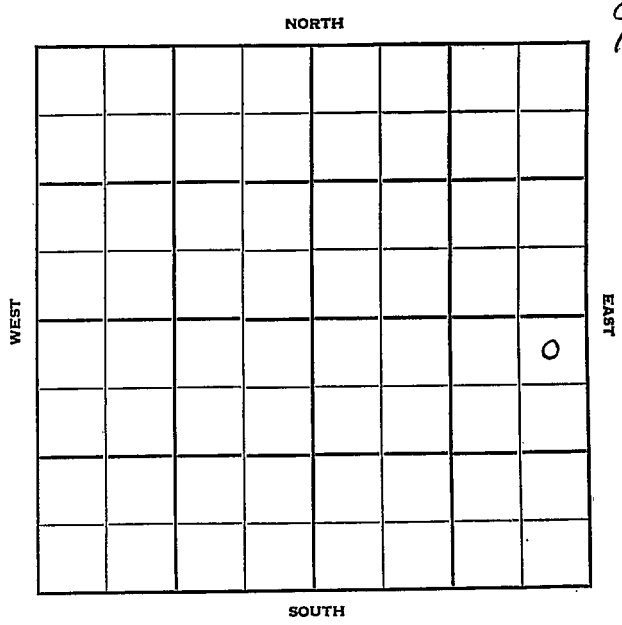

Sec. 6 Twp. 19 R. 12 W ✓

Well No. # 1 Bales Est Farm

J. H. Tatlock Company

Contractor


330 Ft. from N. Line

_____ Ft. from S. Line

330 Ft. from E. Line

_____ Ft. from W. Line

NE NE SE

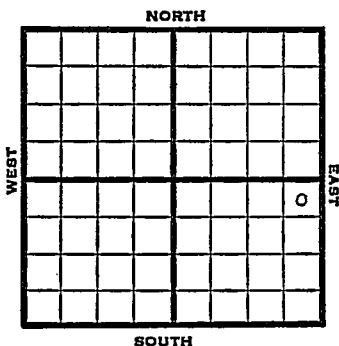

1951

Elev. 1808' REPORT

5/16

R U R

6/5

Spud 5-20-51

D&A TD 3469

8" @ 252 Heeb. 2996

Br Lime 3103 Lans. 3114

Cong. 3356

DST 3204-29 opn 1 hr Rec. 180' mud & SW

DST 3352-3403 opn 30 min. Rec. 6' mud

Arb. 3409-69 TD

D&A

ABANDONED

