

Barton KANSAS

Section 6 Township 19 Range 11 WWell No. # 1 BirzerCompany J. A. Teterling & Sons


NORTH

						0	

SOUTH

WEST

EAST

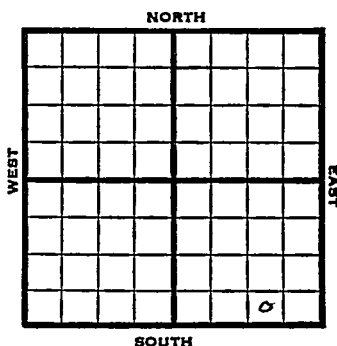Sec. 6 Twp. 19 R. 11WWell No. #1 Birzer FarmJ.A. Teterling & Sons CompanyDuke & Wood Contractor Ft. from N. Line330 Ft. from S. Line330 Ft. from E. Line Ft. from W. Line

1952

1804'

REPORT

11/18 Spud 11-15-52
 8" @ 225'
 Anhy 592'
 Drlg. 1300'

11/27 NR

12/4 Heeb 2941, Lans 3080
 DST 3082-3130, 1/2 hr., 180'
 oil, 240' O&GCM, 1190#
 DST 3241-61, 1 hr., 120' HOCM,
 60' clean oil, 1075#
 Arb. 3358
 RTD 3420
 5" @ 3420

12/11 24/3352-61 24/3365-71 8/3382-84
 1000A HFW PB 3310 40/3243-54 1/2 BOPH
 16% wtr 500A S/4 BOPH

12/18 NR

12/25 NR

1/1 NR

1/8 NR

OVER

#1 Birzer

1953
1/14

Spud 11-15-52

OilWell TD 3420

8" @ 225

Anhy 592, Heeb 2941, Lans
3080

DST 3082-3130, opn $\frac{1}{2}$ hrs.,

Rec. 180' oil, 240' o & gcm
1190#

DST 3241-61, opn 1 hr., rec.

120' hocm, 60' clean oil,
1075#

Arb. 3358,

TD 3420

5" @ 3420

24/3352-61, 24/3365-71, 8/3382-

84, 1000A, HFW


PB 3310 40/3243-54, $\frac{1}{2}$ boph
16% wtr.

500A S/4 boph

Comp. 115 bopd

COMPLETED

County Barton State Kansas
 Sec. 6 (Blk.) 19 (Sur.) 11W Map No.
 Operator J. A. Teterling & Sons
 Well No. 1 Farm Birzer
 Elev. _____ Location SW SE SE

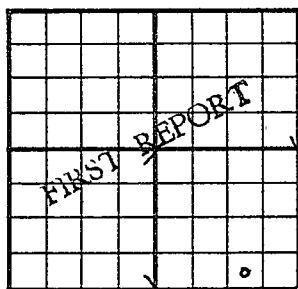

330 Ft. From S Line SE
990 Ft. From E Line Quarter
 1st. Report NOV 19 1957
 Completion _____
 Remarks Duke & Wood - Contr.
 Spudding Date 11-15-52

Drlg. Data

8" @ 225 Anhy 592 drlg. 1300

J. G. McGEHEE

Scout Cards

Land Small Map

Land Wall Map

Tracings

France Map


Pierce Map

Misc.

NOV 21 1952

Drig. Data

County Barton State Kansas
 Sec. 6 (Blk.) 19 (Sur.) 11W Map No.
 Operator J. A. Terteling & Sons
 Well No. 1 Farm Birzer
 Elev. 1804 Location SW SE SE

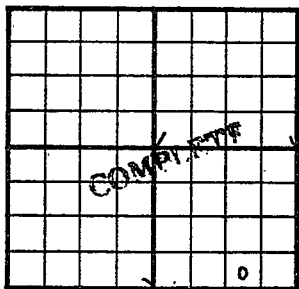

330 Ft. From S Line SE

990 Ft. From E Line Quarter

1st. Report

Completion JAN 14 1953

Remarks

Duke & Wood - Contr.

Spudding Date 11-15-52

Drig. Data Oil well TD 3420

8" @ 225 Anhy 592 Heeb. 2941

Lans. 3080 DST 3082-3130 open $\frac{1}{2}$ hr.

Rec. 180' oil 240' o & gcm 1190#

DST 3241-61 open 1 hr. Rec. 120' hocom

60' clean oil 1075# Arb. 3358

TD 3420 5" @ 3420 24/ 3352-61

24/ 3365-71 8/ 3382-84 1000 A HFW

PB 3310 40/ 3243-54 $\frac{1}{2}$ boph 16% wtr.

500 A S/ 4 boph Comp. 115 bopd

J. G. McGEHEE

Scout Cards	_____
Land Small Map	_____
Land Wall Map	_____
Tracings	_____
France Map	_____
Pierce Map	_____
Misc	_____

JAN 23 1958

Orig. Data