


Section 6 Township 19 Range 11W

Well No. #1 Johnson

Company Keyes Drlg.

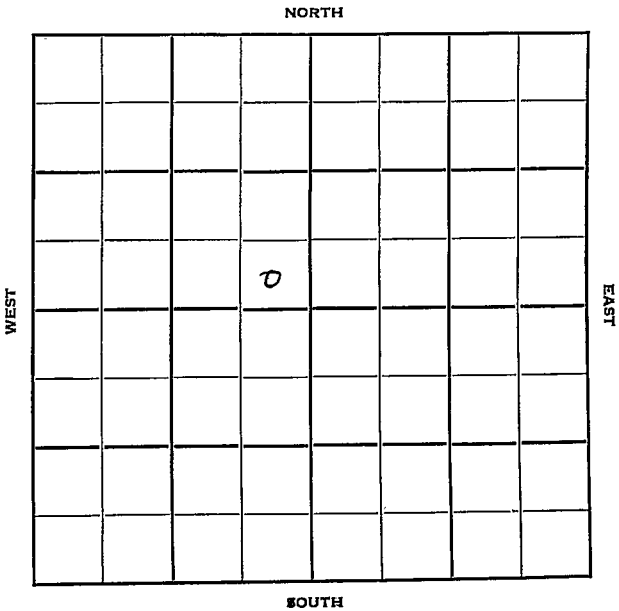

Sec. 6 Twp. 19 R. 11W

Well No. #1 Johnson Farm

Keyes Drlg. Company

Wildcat Contractor


_____ Ft. from N. Line

330' Ft. from S. Line

330' Ft. from E. Line

_____ Ft. from W. Line

SE SE NW

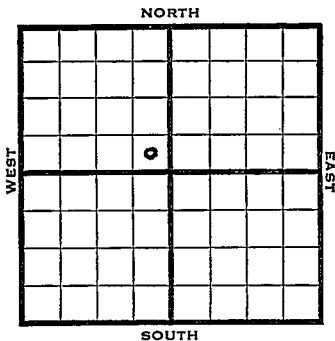

1950 Elev. 1812' REPORT

4/26 Spud 4-22-50
8" @ 193'
Anhy 628'
Drlg. 1265'

5/17 TD 3423
8" @ 193
Lans 3115
Cong 3389
Arb 3396
5" @ 3398
D&A

ABANDONED

Kansas

Wildcat

Map No. _____ Sec. 6 Twp. 19 R. 11W

Well No. 1 Johnson

Keyes Drlg. Company

Contractor

SE SE NW

E1. 1812


SECTION PLAT

_____ Ft. from N. Line

330 Ft. from S. Line

330 Ft. from E. Line

_____ Ft. from W. Line

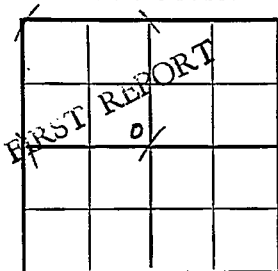

Barton County

Location _____

Rig up _____

Drilling and Remarks:

Spud 4-22-50

8" @ 193

Anhy 628

drlg. 1265

RECORD

Cased _____ in., _____ ft.

Sand _____

Gas _____

Oil _____

Total Depth _____

PRODUCTION

1st 24 hrs. Nat. _____

1st 24 hrs. after shot _____

Gas _____ Cu. Ft.

Dry Hole _____

Abandoned _____

Date

APR 26 1950 19

J. E. TYRA

Scout

TABLE

INDEX

Scout Cards	-----
Land Small Map	-----
Land Wall Map	-----
Tracings	-----
France Map	-----
Pierce Map	-----
Misc.	-----

Handwritten scribbles and a large number '3' over the index table.

NOV 1

NOV 1

Kansas

Map No. _____ Sec. 6 Twp. 19 R. 11W

Well No. 1 Johnson

Keyes Drlg. Company

Contractor

SE SE NW

E1. 1812
SECTION PLAT

_____ Ft. from N. Line

330 Ft. from S. Line

330 Ft. from E. Line

_____ Ft. from W. Line

ABANDONED			

Barton

Location _____

Rig up _____

Drilling and Remarks:

*8" @ 193
Lans 3115
Cang 3389
and 3396
5" @ 3398
D+A*

RECORD

Cased _____ in., _____ ft.

Sand _____

Gas _____

Oil _____

Total Depth 3423

PRODUCTION

1st 24 hrs. Nat. _____

1st 24 hrs. after shot _____

Gas _____ Cu. Ft.

Dry Hole _____

Abandoned _____

Date

MAY 17 1950

J. E. TYRA Scout

Scout Cards

Land Small Map

Land Wall Map


Tracings

France Map

Pierce Map

Misc.


 


























MAY 29 1950

Handwritten notes and signatures, including '8 @ 1/2', 'H. H. P.', and other illegible scribbles.

Scout Cards	YW
Land Small Map	
Land Wall Map	37
Tracings	
France Map	
Pierce Map	
Misc.	