

Section 6 Township 19 Range 11 WWell No. # 1 JohnsonCompany D. R. Lauck

NORTH

			0				

WEST

EAST

SOUTH

Barton

KANSAS

Sec. 6 Twp. 19 R. 11W ✓

Well No. #1 Johnson Farm

D. R. Lauck Company

Contractor


330 Ft. from N. Line

_____ Ft. from S. Line

330 Ft. from E. Line

_____ Ft. from W. Line

NE NE NW

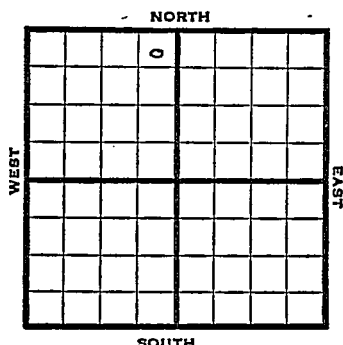

1952

Elev. 1817'

REPORT

2/20

Set surface

3/5

Spud 2-21-52

D & A TD 3435' 8" @ 183

Anhy 635-60' Heeb 2987' Lans. 3116'

DST 3137-72 open 1 hr, rec 60' 0 & GCM

DST 3310-49 open $\frac{1}{2}$ hr, rec 6' mud

Cong. 3381' Arb. 3402'

DST 3375-3412 open $\frac{1}{2}$ hr, rec 30' mud

TD 3435' D & A


ABANDONED

County Barton State Kansas
 Sec. 6 (Blk.) 19 (Sur.) 11W Map No.

Operator D. R. Lauck

Well No. 1 Farm Johnson

Elev. Location NE NE NW

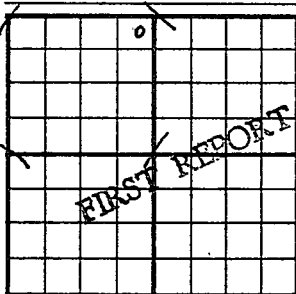

330 Ft. From N Line NW

330 Ft. From E Line Quarter

1st. Report FEB 20 1952

Completion

Remarks

Lauck - Contr.

Spudding Date

Drlg. Data

Set surface

J. G. McGEHEE

Scout Cards

Land Small Map

Land Wall Map

Tracings

France Map


Pierce Map

Misc

FEB 25 1952

Orig. Data

County Barton State Kansas
 Sec. 6 (Blk. Twp.) 19 (Sur. Rge.) 11W Map No. _____
 Operator D. R. Lauck
 Well No. 1 Farm Johnson
 Elev. 1817 Location NE NE NW

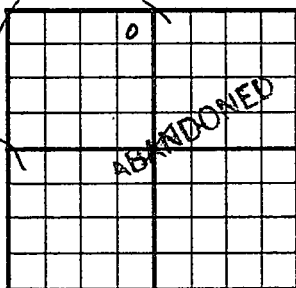

330 Ft. From N Line NW
330 Ft. From E Line Quarter
 Ist. Report _____
 Completion MAR 5 1952
 Remarks _____

Lauck - Contr.

Spudding Date 2-21-52

Drlg. Data D & A TD 3435

8" @ 183 Anhy 635-60 Heeb. 2987

Lans. 3116 DST 3137-72 open 1 hr.

Rec. 60' o & gcm DST 3310-49 open $\frac{1}{2}$ hr.

Rec. 6' mud Cong. 3381 Arb. 3402

DST 3375-3412 open $\frac{1}{2}$ hr. Rec. 30' mud

TD 3435 D & A

J. G. McGEHEE

Scout Cards *mm*
Land Small Map
Land Wall Map *33*
Tracings
France Map
Pierce Map
Misc.

MAR 11 1952

Orig. Data