


DX 78-1 Barton

KANSAS

Section 6 Township 19 Range 11W

Well No. #2 Johnson

Company Fatzer & Boxberger

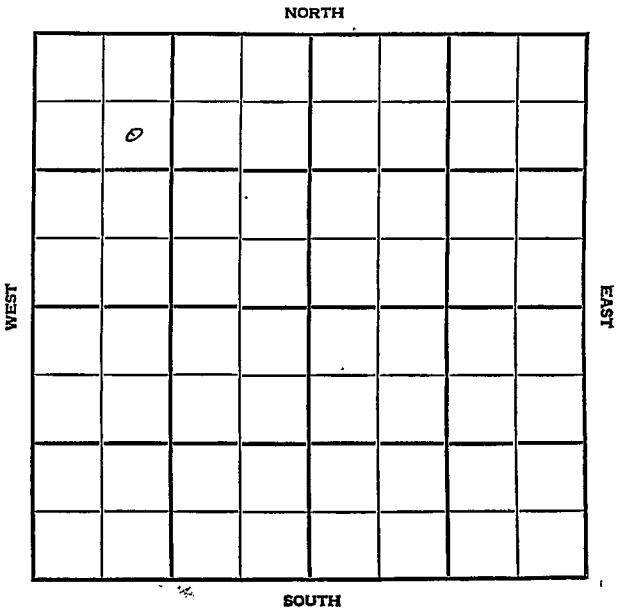

Barton KANSAS


SEC.	TWP.	R.
6	19	11W

WELL NO. 2 Johnson FARM

COMPANY Fatzer & Boxberger

CONTRACTOR Buick

990 Ft. from N. Line
 _____ Ft. from S. Line
 _____ Ft. from E. Line
 990 Ft. from W. Line

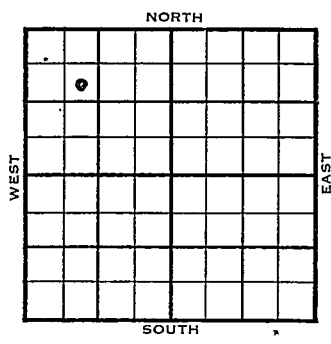

SE NW NW

1954	ELEVATION 1832'	REPORT
------	--------------------	--------

11/3 MIR
 11/23 Spud 11-354 - D&A
 TD 3431'
 8" @ 273'
 Heeb 3003', Br lime 3118', Lans 3134'
 DST 3161-70', opn 1 hr., rec. 15' mud,
 360#
 DST 3181-95', opn 1 hr., rec. 14' mud,
 O#
 B KC 3364', Cong. 3397'
 TD 3431'
 D&A

ABANDONED

NOV 9 1964

Scout Cards	_____	12
Land Small Map	_____	
Land Wall Map	_____	
Tracings	_____	
France Map	_____	
Pierce Map	_____	
Misc.	_____	

NOV 30 1954

Land Use Map	
Land Wall Map	B
Tractings	
France Map	
Picus Map	
Misc.	

Orig. Data