

Barton


KANSAS

SECTION 6 TOWNSHIP 19 RANGE 11 W

WELL NO. #1 Kramp

COMPANY Fatzer, Virginia

NORTH

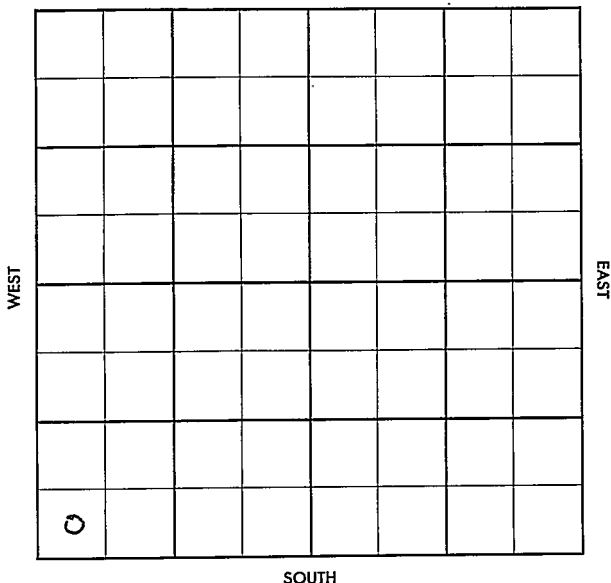

Barton

KANSAS

SEC.	6	TWP.	19	R.	11W
------	---	------	----	----	-----

WELL NO.

#1 Kramp

FARM

COMPANY

Fatzner, Virginia

CONTRACTOR

Virginia

Wildcat


_____ Ft. from N. Line

_____ Ft. from S. Line

_____ Ft. from E. Line

_____ Ft. from W. Line

SW SW SW

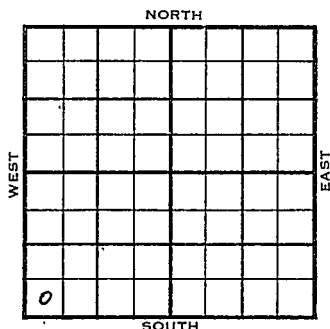

	ELEVATION	REPORT
1955	1810'	
10/2	Comm 10-26-55 8" @ 219/150 Drlg 2705	
11/9	Comm 10-26-55 8" @ 219 w/150 H 2979 Dg 3004 B1 3085 L 3103 Detr 3368 S Arb 3395 DST 3106-40 open 30 min. rec 10' mud 38/20" DST 3268-78 open 1 hr rec 25' wm 1050/30" DST 3363-75 open 50 min rec 27' mud 0/20" DST 3362-92 open 35 min rec 4' mud 0# DST 3396-3403 open 40 min. rec 5' socm 390/30" D & A	

ABANDONED

County Barton Elev. _____
 Sec. 6 Twp. 19 Rge. 11W
 Company Fatzer, Virginia
 Farm Name Kramp No. 1

TOPS	DEPTH	LOG	DATUM	Loc. in Sec.
Anh.				SW SW SW
Tr.				
Dg.				
Bl.				
L.				Geol. _____
K.C.				Contr. _____
B.K.C.				<u>Virginia</u>
Ce.				Pool _____
C.				<u>Wildcat</u>
M.				
M.				
K.				
Mz.				
Me.				
V.				
S.				
S.				
A.				
R.				
Pe.				
G.				
T.D.				

FIRST REPORT

NOV 2 '55

Date Comm. 10-26-55
8" @ 219/150 drlg. 2705

NOV 7 1955

Scout Cards	<i>mm</i>
Land Small Map	
Land Wall Map	
Tracings	
France Map	
Pierce Map	
Misc.	

County Barton Elev. 1810
 Sec. 6 Twp. 19 Rge. 11W
 Company Fatzer, Virginia
 Farm Name Kramp No. 1

TOPS	DEPTH	LOG	DATUM	Loc. in Sec.
Anh.				SW SW SW
Tp.				
H.	<u>2979</u>		<u>1169</u>	
Tr.				
Dg.	<u>3004</u>		<u>1194</u>	
BL.	<u>3085</u>		<u>1275</u>	
L.	<u>3103</u>		<u>1293</u>	
K.C.				Geol.
B.K.C.				Contr.
Ce.				<u>Virginia</u>
C.				
M.				Pool
M.				<u>Wildcat</u>
K.				
Mz.				
Me.				
V.				
S.				
S.				
A. <u>Alto</u>	<u>3368</u>		<u>1558</u>	
R. <u>S. A. L.</u>	<u>3395</u>		<u>1585</u>	
Pe.				
G.				
T.D.	<u>3403</u>			

ABANDONED

Date Comm. 10-26-55 NOV 9 1955
 8" @ 219/150 DST 3106-40 open 30 min.
 rec. 10' mud 38/20" DST 3268-78
 open 1 hr. rec. 25' wmm 1050/30"
 DST 3363-75 open 50 min. rec. 27' mud
 0/20" DST 3362-92 open 35 min.
 rec. 4' mud off " DST 3396-3403
 open 40 min. rec. 5' socm 390/30"

D & A

NOV 17 1955

Scout Cards	<i>mm</i>
Land Small Map	
Land Wall Map	
Tracings	
France Map	
Pierce Map	
Misc.	