


Section 6 Township 19 Range 11WWell No. #1 KrampCompany Lewis Drlg.

NORTH

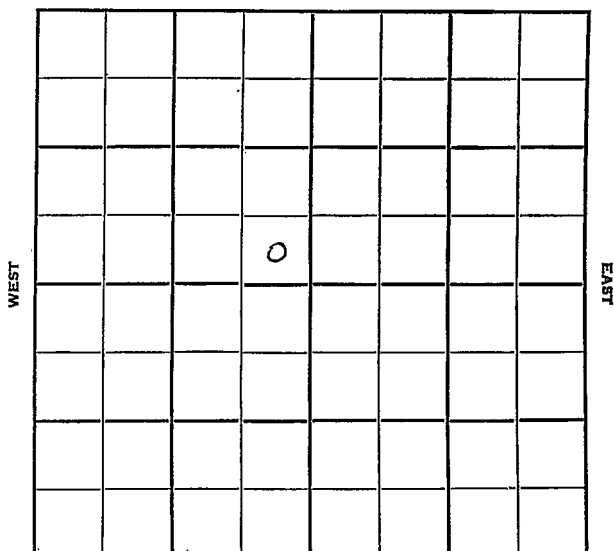

SOUTH

Barton

KANSAS

Sec. 6 Twp. 19 R. 11W

Well No. #1 Kramp Farm

Lewis Drlg. Company

Lewis Drlg. - Contr. Contractor

Wildcat


 Ft. from N. Line

330' Ft. from S. Line

330' Ft. from E. Line

 Ft. from W. Line

SE SE SW

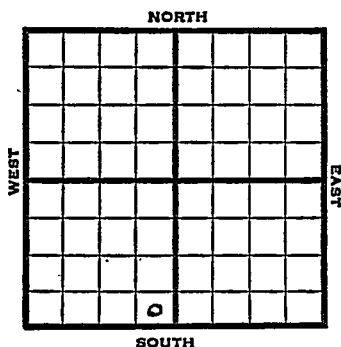

1951

Elev. 1808' REPORT

3/21

RUR

4/18

Spud 3-20-51

D & A TD 3407'

8" @ 311 Anhy 615' Heeb 2965'

Lans. 3099'

DST 3105-31 open 55 min. rec 22' OCM

Arb. 3386', 5" @ 3386' TD 3392

S/2 BOPH 500 A DD 3407'


S/1 1/4 BOPH SP 3290' 16/3271-75

1000 A S/4 BOPH SP 3160'

16/3145-49 24/3124-30 1500 A

water D & A

ABANDONED

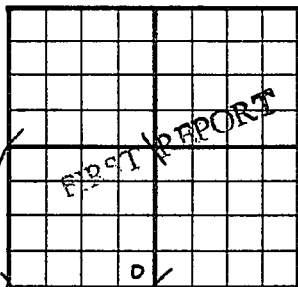County Barton State KansasSec. 6 (Blk.) 19 (Sur.) 11W Map No.Operator Lewis Drlg.Well No. 1 Farm KrampElev. Location SE SE SW330 Ft. From S Line SW330 Ft. From E Line Quarter1st. Report MAR 21 1951

Completion

Remarks

Lewis Drlg. - Contr.

Spudding Date

Drlg. Data WildcatRUR


J. E. TYRA

Scout Cards	
Land Small Map	
Land Wall Map	
Tracings	
France Map	
Pierce Map	
Misc.	

APR 22 1971

Orig. Data

County Barton State Kansas
 Sec. 6 (Blk. 19) (Sur. 11W) (Twp. Map No.)
 Operator Lewis Drlg.
 Well No. 1 Farm Kramp
 Elev. 1808 Location SE SE SW

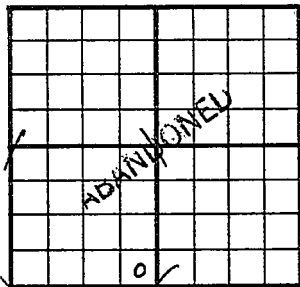

330 Ft. From S Line SW
330 Ft. From E Line Quarter

1st. Report
 Completion APR 18 1951
 Remarks Wildcat
Lewis Drlg. - Contr.
 Spudding Date 3-20-51

Drlg. Data D & A TD 3407
8" @ 311 Anhy 615 Heeb. 2965
Lans. 3099 DST 3105-31 open 55 min.
Rec. 22" ocm Arb. 3386 5" @ 3386
TD 3392 S/ 2 boph 500 A DD 3407
S/ 1½ boph SP 3290 16/ 3271-75 1000 A
S/ 4 bwph SP 3160 16/ 3145-49
24/ 3124-30 1500 A water

D & A

J. E. TYRA

APR 24 1951

Scout Cards mm

Land Small Map

Land Wall Map 5

Trailings

France Map

Pierce Map

WISC:

Drig. Data