

Kansas


Rice

FORM 51 25M 3-49 PETROL

Section 6 Township 19 Range 10W

Well No. #1 Karber

Company Honaker Drlg.

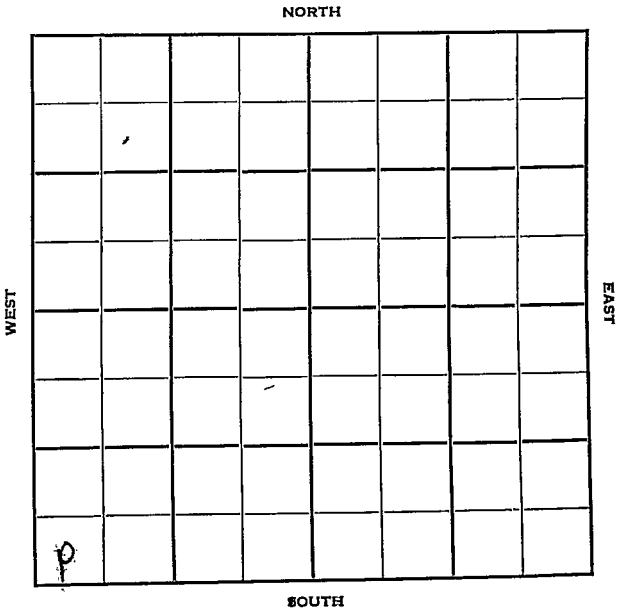

Rice KANSAS

Sec. 6 Twp. 19 R. 10W

Well No. #1 Karber Farm

Honaker Drlg. Company

Rick Pool Contractor


 Ft. from N. Line

330' Ft. from S. Line

 Ft. from E. Line

330' Ft. from W. Line

SW SW SW

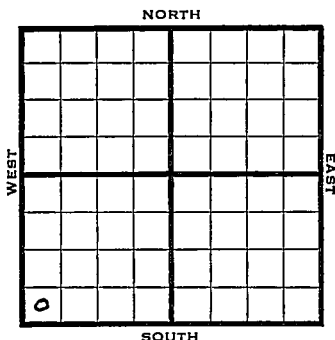

1950 Elev 1775 REPORT

8/9 Spud 7-31-50
8" @ 150'
TD 3209'
Running DST in KC

8/16 8" @ 150
Anhy 650 Top 2643
Heeb 2891 Br lime 3012
Lans 3028
DST 3121-26 opn 1 hr rec 135' sw
Ch Cong 3341
TD 3379
D&A

ABANDONED

County State Kansas

Sec.	(Blk.)	(Sur.)	Map No.
10	(Twp.)	(Rge.)	100

Operator Hensker Eric

Well No. 7 Farm Karher

Elev.	Location	SW	SE	SW
-------	----------	----	----	----

0

230 Ft. From S Line SW

220	Ft. From	Line	Quarter
-----	----------	------	---------

1st. Report AUG 9 1950

Completion

Remarks


Spudding Date 7-31-50

Drlg. Data	Rink Pool

8" @ 150 TD 3209 Running DST in KC

J. E. TYRA

County Rice State Kansas
 Sec. 6 (Blk.) 19 (Sur.) 10W Map No.
 Operator Honaker Drlg.
 Well No. 1 Farm Karber
 Elev. 1775 Location SW SW SW

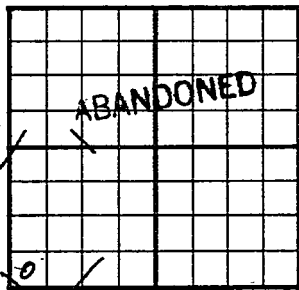

330 Ft. From S Line SW
330 Ft. From W Line Quarter

1st. Report

Completion AUG 16 1950

Remarks

Rick Pool

Spudding Date 7-31-50

Drlg. Data

D & A

TD 3379

8" @ 150 Anhy 650 Top. 2643

Heeb. 2891 Br. lime 3012 Lans. 3028

DST 3121-26 open 1 hr. Rec. 135' sw

Ch. Cong. 3341 TD 3379 D & A

J. E. TYRA