

Section 6 Township 19 Range 10WWell No. #2 MooneyCompany F. G. Hall

NORTH

				0			

WEST

EAST

SOUTH

Rice

KANSAS ✓

Sec. 6 Twp. 19 R. 10WWell No. #2 Mooney FarmF. G. Hall CompanyAllen - Contr. Contractor


330' Ft. from N. Line

Ft. from S. Line

Ft. from E. Line

330' Ft. from W. Line

NW NW NE

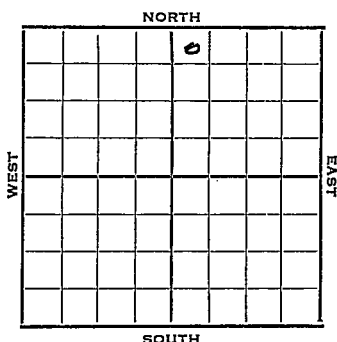

1952	Elev. 1763' REPORT
5/7	RUR
5/14	8" @ 246 Anhy 522 Drlg. 2610'
5/21	Topeka 2616' Heeb 2884' Br li 3004' Lans. 3022' DST 3042-61, 47 mins, 30' GCM, 150' G & CCM, 60' MCO, 30' SW. DST 3163-80 1 hr, 15' M Cong. 3345' DST 3347-65, 1 hr, 240' SW Arb. 3396' TD 3410' 5" @ 3215'
5/28	24/ 3166-70 500 A S/ 1 gal oph PB 3139 24/ 3049-53 1000 A S/ 4 Boph for 8 hrs. POP
6/11	NR
6/18	Spud 5-6-52 Oil Well TD 3410 8" @ 246 Anhy 522 Top 2616 Heeb. 2884 Br Lime 3004 Lans. 3022 DST 3042-61 opn 47 min. Rec. 30' gcm 150' g & ocm 60' mco 30' sw DST 3163-80 opn 1 hr. Rec. 15' mud Cong. 3345 DST 3347-65 opn 1 hr. Rec. 240' sw Arb. 3396 TD 3410 5" @ 3215 24/3166-70 500 A S/1 goph PB 3139 24/3049-53 1000 A S/4 boph Comp. 70 bopd

COMPLETED

County Rice State Kansas
 Sec. 6 (Blk.) 19 (Sur.) 10W Map No.

Operator P. G. Hall

Well No. 2 Farm Mooney

Elev. _____ Location NW NW NE

330 Ft. From N Line NE

330 Ft. From W Line Quarter

1st. Report MAY 7 1952

Completion _____

Remarks _____

Allan - Contr.

Spudding Date _____

Drlg. Data _____

RUR


J. G. McGEHEE

County Rice State Kansas
 Sec. 6 (Blk. 19 (Sur. 10W Map No.)
 (Twp.) (Rge.)

Operator F. G. Hall

Well No. 2 Farm Mooney

Elev. 1763 Location NW NW NE

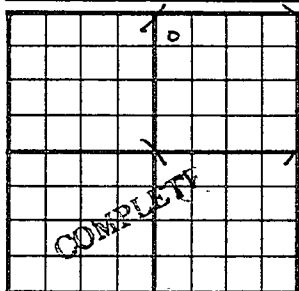

330Ft. From N Line NE

330Ft. From W Line Quarter

1st. Report

Completion JUN 1 8 1952

Remarks

Allan - Contr.

Spudding Date 5-6-52

Drlg. Data Oil well TD 3410

8" @ 246 Anhy 522 Top. 2616

Heeb. 2884 Br. lime 3004 Lans. 3022

DST 3042-61 open 47 min. Rec. 30' gcm

150' g & ocm 60' mco 30' sw DST 3163-

80 open 1 hr. Rec. 15' mud Cong. 3345

DST 3347-65 open 1 hr. Rec. 240' sw

Arb. 3396 TD 3410 5" @ 3215

24/ 3166-70 500 A S/ 1 goph PB 3139

24/ 3049-53 1000 A S/ 4 boph

Comp. 70 bopd

J. G. McGEHEE