


McPherson

KANSAS

Section 6 Township 19 Range 2 W

Well No. #1 Williams

Company Geo. Hess

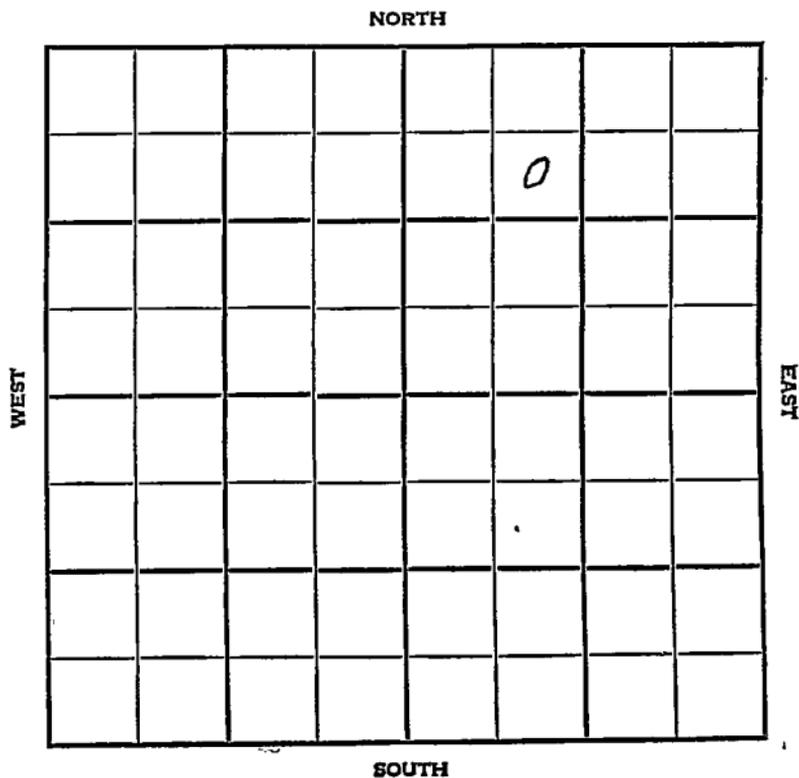

McPherson

KANSAS

SEC.	TWP.	R.
6	19	2W

WELL NO. #1 Williams FARM

COMPANY Geo. Hess

CONTRACTOR Mallard


McPherson

\_\_\_\_\_ Ft. from N. Line

\_\_\_\_\_ Ft. from S. Line

\_\_\_\_\_ Ft. from E. Line

\_\_\_\_\_ Ft. from W. Line

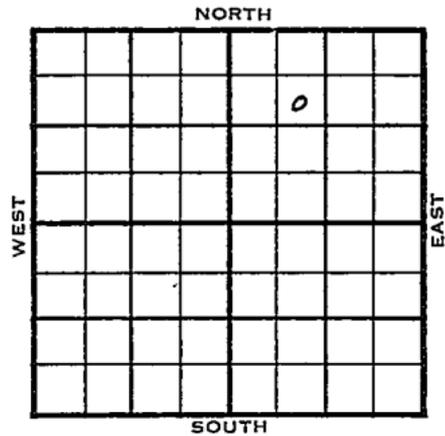

SE NW NE

1955	ELEVATION 1552'	REPORT
------	--------------------	--------

10/12 Comm 10-10-55  
 8" @ 159/90  
 WOC

11-30 5 1/2" @ 2999  
 CO to 3002  
 DD 3008 1/2 BWPH, 100 mcf  
 DD 3017  
 S/ 1 BOPH, 1/2 BWPH, 1000 A  
 Comp. 3 BOPD  
 Chat 2986  
 TD 3017'

COMPLETED

County McPherson Elev. \_\_\_\_\_  
 Sec. 6 Twp. 19 Rge. 2W  
 Company Geo. Hess  
 Farm Name Williams No. 1

TOPS	DEPTH	LOG	DATUM	Loc. in Sec.
Anh.				SE NW NE
Tr.				
H.				
Tr.				
Dg.				
Bl.				
L.				Geol. _____
K.C.				Contr. _____
B.K.C.				
Ce.				
C.				<u>Mallard</u>
M.				Pool _____
M.				
K.				<u>McPherson</u>
Mz.				
Mq.				
V.				
S.				
S.				
A.				
R.				
Pe.				
G.				
T.D.				

DEC 12 1955  
 FIRST REPORT

Date Comm. 10-10-55  
8" @ 159/90 WOC

Co.  
Lse.  
No.  
Sec.  
T.  
R.

County McPherson Elev. 1552  
 Sec. 6 Twp. 19 Rge. 2W  
 Company Geo. Hess  
 FarmName Williams No. 1

TOPS	DEPTH	LOG	DATUM	Loc. in Sec.																														
Anh.				SE NW NE																														
TP.																																		
H.																																		
Tr.																																		
Dg.																																		
Bl.																																		
L.				Geol.																														
K.C.				Contr.																														
B.K.C.				<u>Mallard</u>																														
Ce.				Pool																														
C.				<u>McPherson</u>																														
M.	<u>Chat 2986</u>		<u>1434</u>	<table border="1"> <tr><td></td><td></td><td></td></tr> </table>																														
M.																																		
K.																																		
Mz.																																		
Ma.																																		
V.																																		
S.																																		
S.																																		
A.																																		
R.																																		
PE.																																		
G.																																		
T.D.	<u>3002</u>																																	

Date Comm. 10-10-55 NOV 30 1955  
 8" @ 159/90 5 $\frac{1}{2}$ " @ 2999 CO to 3002  
 DD 3008  $\frac{1}{2}$  bwph 100 mcfg DD 3017  
 S/ 1 boph  $\frac{1}{2}$  bwph 1000 A  
 Comp. 3 bopd

Co.  
 Lse.  
 No.  
 Sec.  
 T.  
 R.