


Section 6 Township 19 Range 2-W

Well No. #1 Williams

Company Harvey Creek et. al

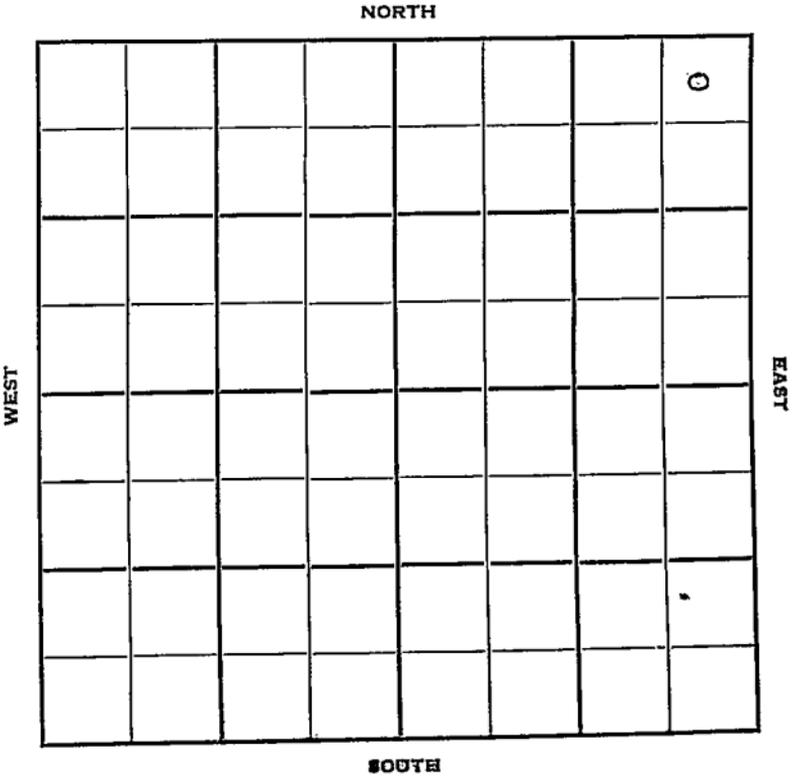

McPherson

KANSAS
2W

Sec. 6 Twp. 19 R. 2W

Well No. #1 Williams Farm

Harvey Creek et al Company

Contractor


330' Ft. from N. Line

Ft. from S. Line

330' Ft. from E. Line

Ft. from W. Line

NE NE NE

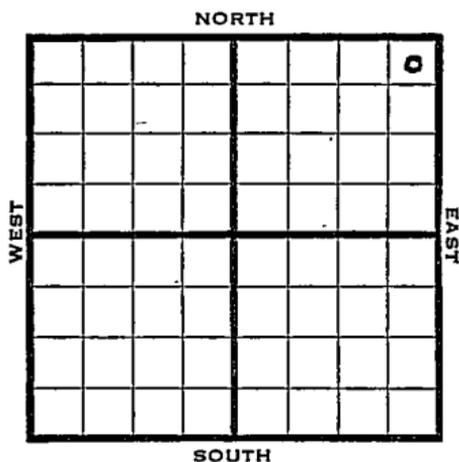

1950 Elev. 1553' REPORT

8/23 MIM

1951

2/28 Spud 10-20-50
 Oil Well TD 3000
 8" @ 95'
 Chat 2973'
 4 1/2" @ 2937
 TD 3000
 Comp. 15 bopd 50% wtr

COMPLETED

County McPherson State Kansas

Sec. 6 (Blk. 19) (Sur. 2W) Map No.

Operator Harvey Creek et al.

Well No. 1 Farm Williams

Elev. _____ Location NE NE NE

330 Ft. From N Line NE

330 Ft. From E Line Quarter

1st. Report AUG 23 1950

Completion _____

Remarks _____

Spudding Date _____

FIRST REPORT

Drig. Data _____

M I H

County McPherson State Kansas

Sec. 6 (Blk. 19) (Sur. 2W) (Twp.) (Rge.) Map No.

Operator Harvey Creek etal.

Well No. 1 Farm Williams

Elev. 1553 Location NE NE NE

330 Ft. From N Line NE

330 Ft. From E Line Quarter

Ist. Report

Completion FEB 28 1951

Remarks McPherson Pool

Spudding Date 10-20-50

Drilg. Data Oil well TD 3000

8" @ 95 Chat 2973 4 1/2" @ 2937 TD 3000

Comp. 15 bopd 50% water

J. E. TYRA