

KANSAS

Mcpherson


FORM 51 5M 4-41 PETROL

Section 6 Township 19 Range 2-W

Well No. #1 Anderson

Company Olson Oil

NORTH Ritz Canton Pool

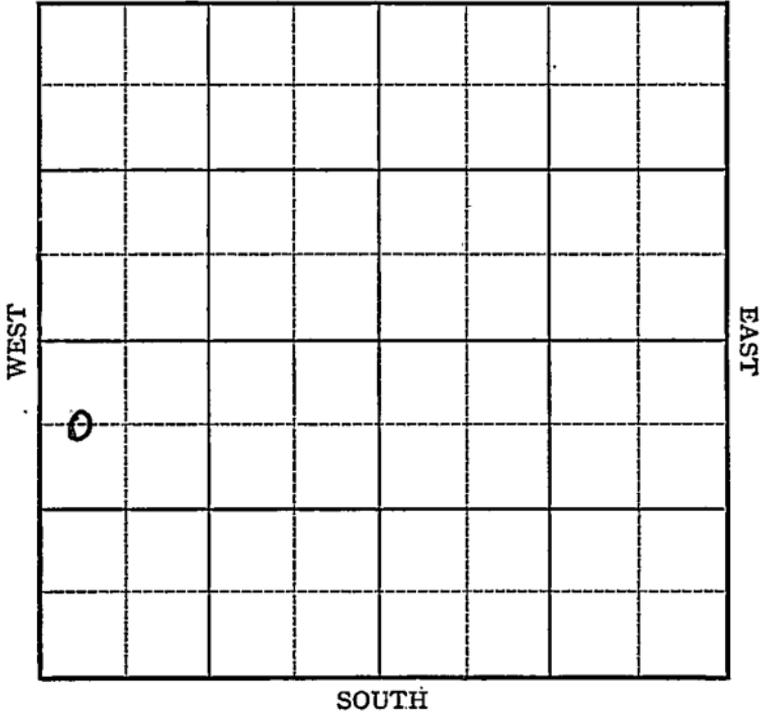

Map No. 43 Sec. 6 Twp. 19 R. 2WWell No. 1 AndersonOlson Oil CompanyFIRST REPORT Contractor**SECTION PLAT**

C W L NW SW

660 Ft. from N. Line

_____ Ft. from S. Line

_____ Ft. from E. Line

330 Ft. from W. Line

RETZ CANTON POOL

Location _____

Rig up _____

Drilling and Remarks:

Rotary**RECORD**

Cased _____ in., _____ ft.

Sand _____

Gas _____

Oil _____

Total Depth _____

PRODUCTION

1st 24 hrs. Nat. _____

1st 24 hrs. after shot _____

Gas _____ Cu. Ft.

Dry Hole _____

Abandoned _____

Date

MAY 21 1944 19S. J. LEWIS Scout

Map No. 43 Sec. 6 Twp. 19 R. 2WWell No. 1 AndersonOlson Oil CompanyABANDONED Contractor**SECTION PLAT**

C W L NW SW

660 Ft. from N. Line

_____ Ft. from S. Line

_____ Ft. from E. Line

330 Ft. from W. Line

RITZ CANTON POOL

b			

Location _____

Rig up _____

Drilling and Remarks:

*Chas 2995**No shows***RECORD**

Cased _____ in., _____ ft.

Sand _____

Gas _____

Oil _____

Total Depth 3006**PRODUCTION**

1st 24 hrs. Nat. _____

1st 24 hrs. after shot _____

Gas _____ Cu. Ft.

Dry Hole _____

Abandoned _____

Date

JUN 11 1941 19S. J. LEWIS Scout