

McPherson

DX 78-1

KANSAS

Section 6 Township 19 Range 2W

Well No. #1 Fernberg

Company Law & Moore et al

NORTH

	0						

WEST

EAST

SOUTH

McPherson KANSAS

SEC. 6	TWP. 19	R. 2W
-----------	------------	----------

WELL NO. 1 Fernberg FARM

COMPANY Law & Moore et al

CONTRACTOR Mallard Drlg.


McPherson Pool

330 Ft. from N. Line

Ft. from S. Line

Ft. from E. Line

990 Ft. from W. Line

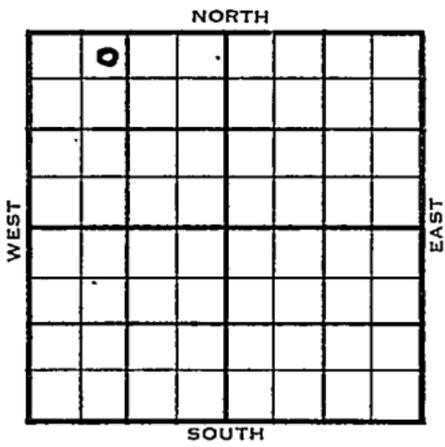

NE NW NW

1954	ELEVATION 1538'	REPORT
------	--------------------	--------

8/25 Spud 8-20-54  
8" @ 158'  
Drlg. 1647'

9/22 Spud -  
D & A  
TD 2992'  
8" @ 158'  
KC 2338', Miss 2981',  
TD 2992'  
5" @ 2990'  
1 boph 4 1/2 " liner @ 3031'  
PB 3037'  
40/ 3025-35 FU 1250' wtr 14 hr  
D & A

**ABANDONED**

County **McPherson** State **Kansas**

Sec. **6** (Blk. Twp.) **19** (Sur. Rge.) **2W** Map No.

Operator **Law & Moore et al.**

Well No. **1** Farm **Fernberg**

Elev. Location **NE NW NW**



**330** Ft. From **N** Line **NW**

**990** Ft. From **W** Line **Quarter**

Ist. Report **AUG 25 1954**

Completion

Remarks

**Mallard Drlg. - Contr.**

Spudding Date **8-20-54**

Drlg. Data **McPherson Pool**

**8" @ 158 drlg. 1647**

**FABEN, GILSTRAP**


County McPherson State Kansas

Sec. 6 (Blk. 19) (Sur. 2W) (Twp. 19) (Rge. 2W) Map No.

Operator Law & Moore etal.

Well No. 1- Farm Fernberg

Elev. 1538 Location NE NW NW

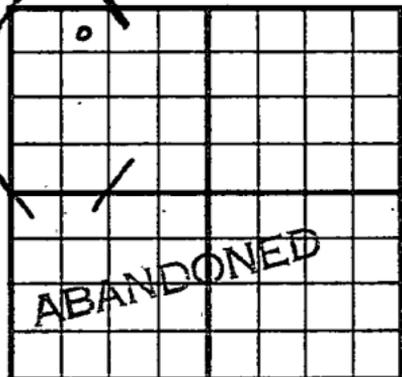

330 Ft. From N Line NW

990 Ft. From W Line Quarter

1st. Report Aug 25 1954

Completion SEP 22 1954

Remarks:

Mallard Drlg. - Contr.

Spudding Date

Drlg. Data D & A TD 2992 McPherson Pool

8" @ 158 KC 2338 Miss. 2981

TD 2992 5" @ 2990 1 boph 4 1/2" liner @

3031 PB 3037 40/ 3025-35 FU 1250'

wtr. 14 hr.

D & A

FABEN GILSTRAP