

Mc Pherson

Map No. **KANSAS** Sec. *6* Twp. *19* R. *2 W*

Well No. *1 Paulsen* Farm


Jess Kling Company

330 Ft. from N. Line

..... Ft. from S. Line

330
~~*290*~~ Ft. from E. Line

..... Ft. from W. Line

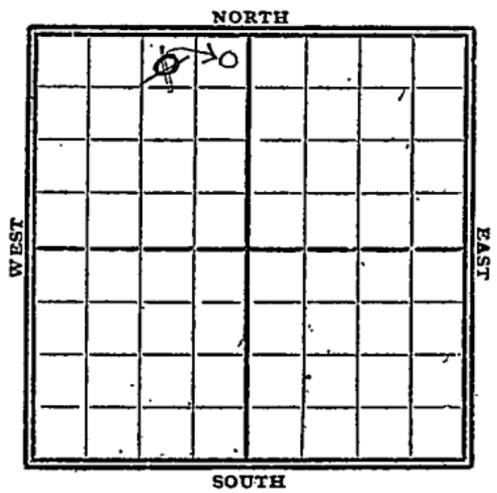

Date
1934

REPORT

<i>4/4</i>	<i>Location</i>
<i>4/12</i>
<i>4/19</i>	<i>Dlg 130</i>
<i>4/26</i>	<i>" 1165 10" 1070</i>
<i>5/3</i>	<i>" 2095 8" 1502</i>
<i>5/10</i>	<i>" 2375 6 7/8 2115 KC 2328</i>
<i>5/18</i>	<i>TD 2392 2000 acid</i> <i>5 Bbls per hr.</i>
<i>5/25</i>
<i>5/30</i>	<i>Top K.C.L. 2328 TD 2392</i> <i>2000 gal acid Pump 35 Bbls.</i>

COMPLETED

Map No. 43 Sec. 6 Twp. 19 R. 2W

Well No. 1-paulsen

Just Cling Company
Contractor

FIRST REPORT

SECTION PLAT

330 Ft. from N. Line

_____ Ft. from S. Line

990 Ft. from E. Line

_____ Ft. from W. Line

	0		

Location ✓

Rig up _____

Drilling and Remarks:

RECORD

Cased _____ in., _____ ft.

Sand _____

Gas _____

Oil _____

Total Depth _____

PRODUCTION

1st 24 hrs. Nat. _____

1st 24 hrs. after shot _____

Gas _____ Cu. Ft.

Dry Hole _____

Abandoned _____

Date

11-4-34 1934 Marin Schreel Scott

Map No. 43 Sec. 6 Twp. 19 R. 2W

Well No. 1 - Paulsen

Just Cling Company

Contractor

CORRECTION

330 Ft. from N. Line

_____ Ft. from S. Line

330 Ft. from E. Line

_____ Ft. from W. Line

SECTION PLAT

<u>0</u>			

CORRECTION

Location _____

Rig up _____

Drilling and Remarks:

*Reported
NW NE NW*

*Change
NE NW*

RECORD

Cased _____ in., _____ ft.

Sand _____

Gas _____

Oil _____

Total Depth _____

PRODUCTION

1st 24 hrs. Nat. _____

1st 24 hrs. after shot _____

Gas _____ Cu. Ft.

Dry Hole _____

Abandoned _____

Date

4-25-34 19 _____

IRVING MANNISCHRECK
Scout

M. J. Jenson

Map No. 43 Sec. 6 Twp. 19 R. 2W

Well No. 1 Paulsen

Jess Ching Company
Jess Ching Contractor

SECTION PLAT

	0		
	COMPLETE		

230 Ft. from N. Line

_____ Ft. from S. Line

230 Ft. from E. Line

_____ Ft. from W. Line

Location _____

Rig up _____

Drilling and Remarks:

Top KCL 2328
TD 2392
2000 gal acid
Pump 35 ft

RECORD

Cased _____ in., _____ ft.

Sand _____

Gas _____

Oil _____

Total Depth _____

PRODUCTION

1st 24-hrs. Nat. _____

1st 24 hrs. after shot _____

Gas _____ Cu. Ft.

Dry Hole _____

Abandoned _____

Date

5/30 1934

ORVAL MANNSCHRECK
 Scout