
FORM 51 McPherson KANSAS

Section 6 Township 19 Range 2W

Well No. 1 Vandeman

Company Geo. Hess & Larry Moore

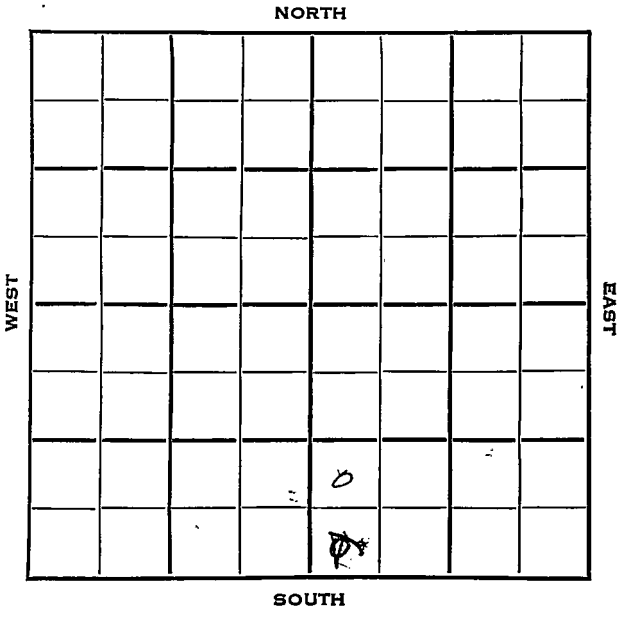

McPherson KANSAS

SEC.	TWP.	R.
6	19	2W

WELL NO.

. #1 Vandeman FARM

COMPANY

Geo. Hess & Larry Moore

CONTRACTOR

Mallard Drlg.

Lively Pool


~~990~~ Ft. from N. Line

~~330~~ Ft. from S. Line

Ft. from E. Line

330 Ft. from W. Line

~~NW~~ ~~SW~~ SW SE

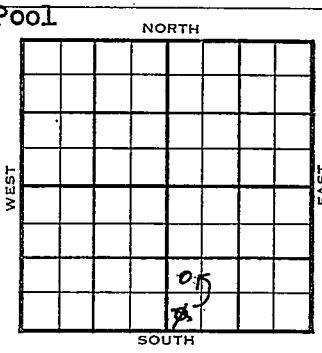

	ELEVATION	REPORT
1954	1548'	
3/24		Location
3/31		8" @ 156 w/110 Drlg. 1530'
4/7		Lans 2342', Miss 2948' RTD 2988' 5" @ 2987'
5/19		Spud 3-26-54 Oil well TD 2994 8" @ 156 Lans. 2342 Miss 2948 TD 2988 5" @ 2987 DD 2994 S & F/30 BOPD 100,000 CFG F/15 BOPD Comp.

COMPLETED

DX-78

FORM 275 FOR SALE BY KANSAS BLUE PRINT CO.

County McPherson State Kansas

Sec. 6 (Blk. Twp.) 19 (Sur. Rge.) 2W Map No.

Operator Geo. Hess & Larry Moore

Well No. 1 Farm Vandeman

Elev. Location SW SW SE



330 Ft. From S Line SE

330 Ft. From W Line Quarter

1st. Report MAR 24 1954

Completion

Remarks Mallard Drlg. - Contr

Spudding Date

Drlg. Data Lively Pool

Location

J. G. McGEHEE

FORM 26 200 BKS. 4-52 PETROL

Kansas

Map No. _____ Sec. 6 Twp. 19 R. 2W


Well No. 1 Vandeman

Geo. Hess & Larry Moore Company

CORRECTION Contractor

NW SW SE

SECTION PLAT

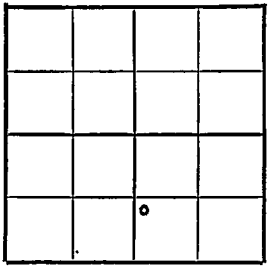

_____ Ft. from N. Line

990 Ft. from S. Line

_____ Ft. from E. Line

330 Ft. from W. Line

McPherson County

Location _____

Rig up _____

Drilling and Remarks:

Reported
SW SW SE

RECORD

Cased _____ in., _____ ft.

Sand _____

Gas _____

Oil _____

Total Depth _____

PRODUCTION

1st 24 hrs. Nat. _____

1st 24 hrs. after shot _____

Gas _____ Cu. Ft.

Dry Hole _____

Abandoned _____

Date

MAR 31 1954 19

J. G. McGEHEE Scout

FORM 275 FOR SALE BY KANSAS BLUE PRINT CO.


County McPherson State Kansas

Sec. 6 (Blk. Twp.) 19 (Sur. Rge.) 2W Map No.

Operator Geo. Hess & Larry Moore

Well No. 1 Farm Vandeman

Elev. 1548 Location NW SW SE

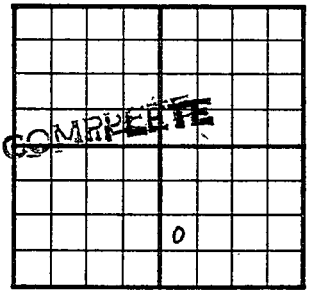

990 Ft. From S Line SE

330 Ft. From W Line Quarter

1st. Report

Completion MAY 19 1954

Remarks Lively Pool

Mallard Drlg. - Contr.

Spudding Date 3-26-54

Drlg. Data Oil well TD 2994

8" @ 156 Lans. 2342 Miss. 2948

TD 2988 5" @ 2987 DD 2994

S & F/ 30 bopd 100,000 cfg F/ 15 bopd

Comp.

J. G. McGEHEE