

KANSAS


FORM 51 5M 6-46 PETROL

McPherson County

Section 6 Township 19 Range 2W

Well No. #2 Williams

Company R. E. Youker

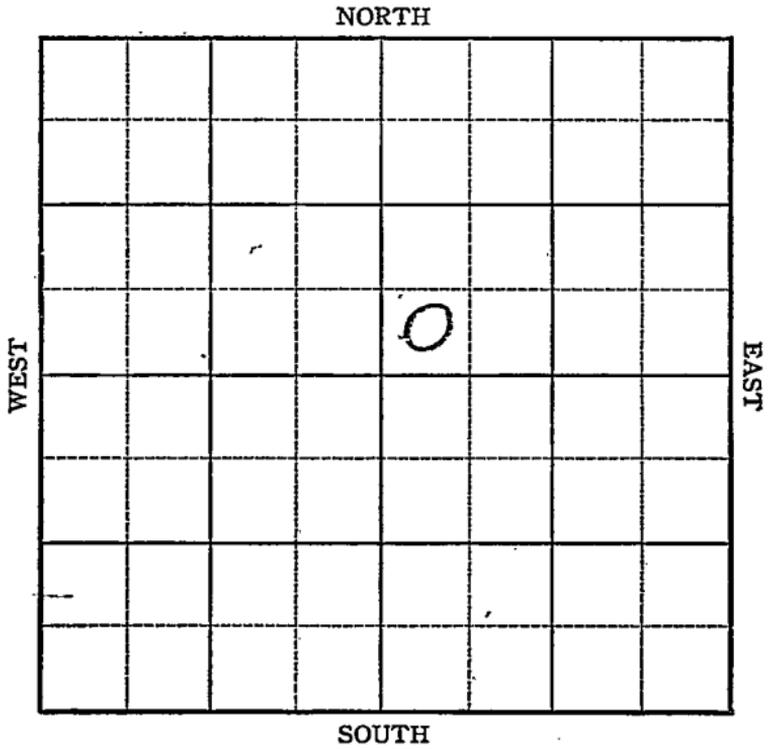

Sec. 6 Twp. 19 R. 2W

Well No. #2 Williams Farm

R. E. Youker Company


McPherson

         Ft. from N. Line

330 Ft. from S. Line

         Ft. from E. Line

330 Ft. from W. Line

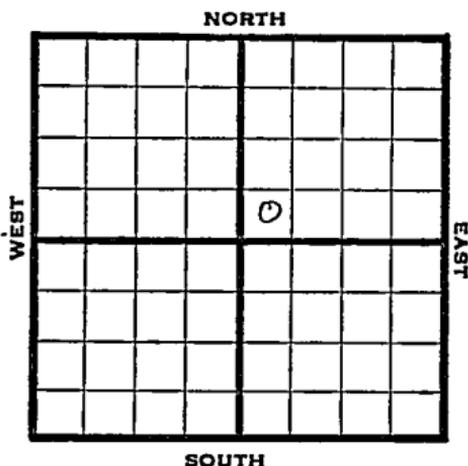

SW NE

1946

*1553*

REPORT

7/17	Location
7/23	Mach
7/30	13" @ 410 Drlg 775'
8/6	1490 Run 10"
8/13	10" @ 1490' 8" @ 1815 Drlg 2080'
8/20	Drlg 2295'
8/27	KC 2358' TD 2380-5" @ 2360 WOC
9/5	" " " "
9/11	KC 2358' 5" @ 2360' TD 2384 Acid 3000 gal Pump 50 POT Grav 36


**COMPLETE**

KANSAS

Kansas Pool Name McPhersonMap No. 23 Sec. 6 Twp. 19 R. 2WWell No. 2 WilliamsR. E. Youker CompanyFIRST REPORT Contractor

SW NE

## SECTION PLAT

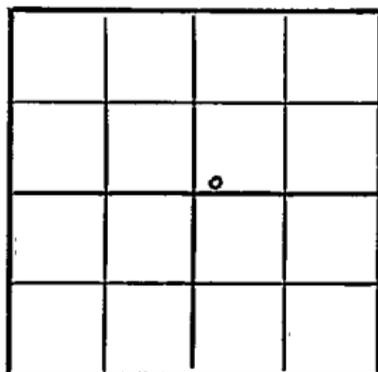           Ft. from N. Line330 Ft. from S. Line           Ft. from E. Line330 Ft. from W. LineMcPherson CountyLocation XRig up           Drilling and Remarks:           

## RECORD

Cased            in.,            ft.Sand           Gas           Oil           Total Depth           

## PRODUCTION

1st 24 hrs. Nat.           1st 24 hrs. after shot           Gas            Cu. Ft.Dry Hole           Abandoned           

Date

JUL 17 1946 19S. J. LEWIS Scout

