Barton


KANSAS

SECTION 6 TOWNSHIP 19S RANGE 14W

WELL NO. #1 P. Dyer "B"

COMPANY The Texas Co.

NORTH NW NW NW

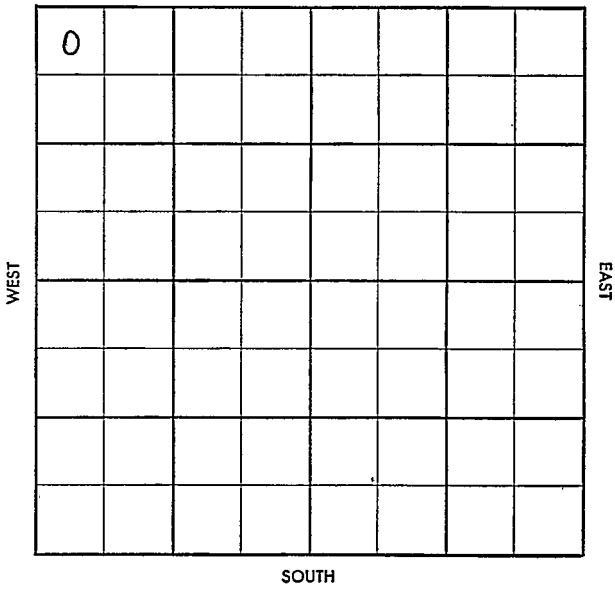

Twp. X Pool X

Co. X Facet 13

S-513-B

County Barton Elev.

Sec. 6 Twp. 19 Rge. 14W

Company The Texas Co.

Farm Name P. Dyer "B" No. 1

TOPS	DEPTH	LOG	DATUM
Anh.			
Tp.			
H.			
Tr.			
Dg.			
B.L.			
L.			
K.C.			
B.K.C.			
Ce.			
C.			
M.			
M.			
K.			
Mz.			
Mq.			
V.			
S.			
S.			
A.			
R.			
Pf.			
G.			
T.D.			

Loc. in Sec. NW NW NW

Geol.

Contr.

Pool Merten NE



Date Comm. 7-3-58

10" @ 890, Drlg. 2540

Co. Lse. No. Sec. T. R.

Twp. X Pool X

Co. X Facet X

S-513-B

County Barton Elev. 1895 DF 1898 RB

Sec. 6 Twp. 19 Rge. 14W

Company The Texas Co.

Farm Name P. Eyer "B" No. 1

TOPS	DEPTH	LOG	DATUM
Anh.			
Tp.			
H.		3131	
Tr.		3147	
Dg.			
B.L.		3210	
L.		3218	
K.C.			
B.K.C.			
Ce.			
C.		3246	
M.			
M.			
K.			
Mz.			
Mq.			
V.			
S.			
S.			
A.		3532	
R.			
Pf.			
G.			
T.D.	3596	3586	

Loc. in Sec. NW NW NW

Geol.

Contr.

Pool Merton NE

ABANDONED JUL 16 '58

Date Comm. 7-3-58

10" @ 890, Drlg. 2540 JUL 16 '58 DST 3354-72 ½ hr 12'M BHP 30/30" DST 3531-40 30" 12'M BHP 945/20" DST 3536-50 1 hr 20'M BHP 1065/30" DST 3550-65 1 hr 305' SW BHP 1100/30"

D&A

Co. Lse. No. Sec. T. R.